

MISSISSIPPI DEPARTMENT OF NATURAL RESOURCES

Bureau of Land and Water Resources

Southport Mall

P.O. Box 10631

Jackson, Mississippi 39209

WATER WELL DRILLERS LOG

Harrison
H
2361

11/20/85 19__
 date well/completed

Harrison
 firm name
COASTAL DRILLING & SERVICE CO.
 by well located

RT. 11, BOX 81
 location

LANDOWNER: Reg Adams

description of formations
BILOXI, MS 38532
 location

Mill Creek Csts.

Biloxi, ms
 (mailing address)

WELL LOCATION:

sec 33 T 6 N R W E
S W
 (distance) miles (direction) of (nearest town)

WELL PURPOSE: home
 (home, irrigation, municipal, industrial)

WELL COMPLETION DATA:

- (1) diameter (inches) 2'
- (2) total depth (feet) 640
- (3) static water level (feet) 10 below above top of ground.
- (4) casing pvc, 120
 (material) (depth)
 (size) if telescope see back.
- (5) screen 15', 630
 (length) (depth to top)
2', pvc
 (size) (material)
- (6) pump 2 14
 (HP) (yield gpm)
elec.
 (type power)
- (7) electric log no.
 (yes or no)
 (organization running log)
- (8) how well bottom plugged 2' back
wash valve

DRILLERS REMARKS:


description of formations	from	to
top soil	1	7
red clay	7	195
soft blue clay	195	400
hard blue clay	400	590
fine water sand	590	630
good water sand	630	640

RECEIVED
 MAY 19 1986

Department of Natural Resources
 Bureau of Land & Water

If well telescopes please sketch and show depths.

GROUND LEVEL

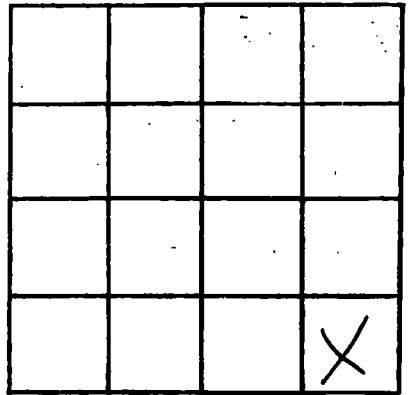

SECTION _____

Please indicate well location X.

ADDITIONAL INFORMATION

If more than one screen, show locations of each on sketch.