

MISSISSIPPI DEPARTMENT OF NATURAL RESOURCES

Bureau of Land and Water Resources

Southport Mall

P.O. Box 10631

Jackson, Mississippi 39209

WATER WELL DRILLERS LOG

COASTAL DRILLING & SERVICE CO.

JACKSON
H
2362

11/23/85

date well completed 19

RT. 11, BOX 81

Harrison
county well located

BILOXI, MS 39532

LANDOWNER Jucille Spigler

description of formations encountered

from

to

off Walker Rd.
Biloxi, Ms.
(mailing address)

top soil	1	5
red clay	5	190
blue clay	190	255
good water sand	255	265

WELL LOCATION:

sec 30 T 6 S R 10 E W
Biloxi of
(distance) miles (direction) (nearest town)

WELL PURPOSE: home
(home, irrigation, municipal, industrial)


WELL COMPLETION DATA:

- (1) diameter (inches) 4" x 2"
- (2) total depth (feet) 265
- (3) static water level (feet) 15 below above top of ground.
- (4) casing pvc 105 (material) (depth)
4" x 2" (size) if telescope see back.
- (5) screen 15' (length) 250 (depth to top)
2" (size) pvc (material)
- (6) pump 1 (HP) 9 (yield gpm)
Etc. (type power)
- (7) electric log no (yes or no)

(organization running log)

(8) how well bottom plugged 2' back
wash valve.

DRILLERS REMARKS:

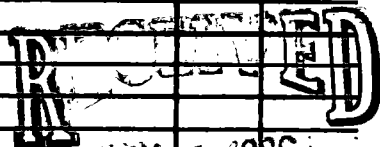


MAY 19 1986

Department of Natural Resources
Bureau of Land and Water Resources

If well telescopes please sketch and show depths.

GROUND LEVEL

160' 4" pvc casing

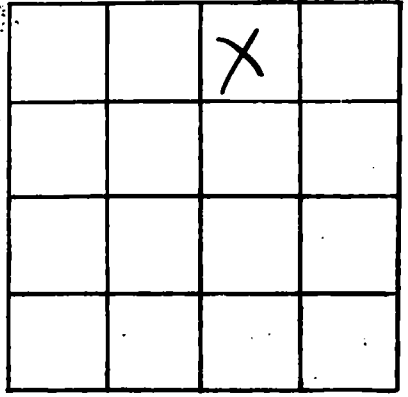

SECTION _____

Please indicate well location X.

ADDITIONAL INFORMATION

105' 2" pvc casing

15' 2" pvc screen
2" backwash valve

If more than one screen, show locations of each on sketch.