

MISSISSIPPI DEPARTMENT OF NATURAL RESOURCES

Bureau of Land and Water Resources

Southport Mall

P.O. Box 10631

Jackson, Mississippi 39209

WATER WELL DRILLERS LOG

HARRIS J  
H  
2364

COASTAL DRILLING & SERVICE - Carrollton

RT. 11, BOX 81

11/23/85 date well completed

county well located

LANDOWNER: Jam Sarrat

Beloxi, MS 39533

Rt. 11 Box 628

top soil

from

to

1 15

Beloxi, Ms.

red clay

15 210

(mailing address)

soft blue clay

210 480

WELL LOCATION:

hard blue clay

480 565

sec 2 T 6N R 19E S W

fine water sand

565 600

Woolmarket

red clay

600 730

(distance) miles (direction) of (nearest town)

fine water sand

730 740

good water sand

740 750

WELL PURPOSE:

home

(home, irrigation, municipal, industrial)

WELL COMPLETION DATA:

(1) diameter (inches) 4" x 2"

(2) total depth (feet) 750

(3) static water level (feet) 20 below top of ground.

(4) casing PVC 735  
(material) (depth)

4" x 2" if telescope see back.  
(size)

(5) screen 15' 735  
(length) (depth to top)

2" PVC  
(size) (material)

(6) pump 1 8  
(HP) (yield gpm)

etc.  
(type power)

(7) electric log no  
(yes or no)

(organization running log)

(8) how well bottom plugged 2" back  
wash valve

DRILLERS REMARKS:

WARRANTY  
MAY 1 1986

Department of Natural Resources  
Bureau of Land & Water Resources

If well telescopes please sketch and show depths.

GROUND LEVEL


160' 4" pvc casing

390' 2" pvc casing

15' 2" pvc screen

2" backwash valve

If more than one screen, show locations of each on sketch.

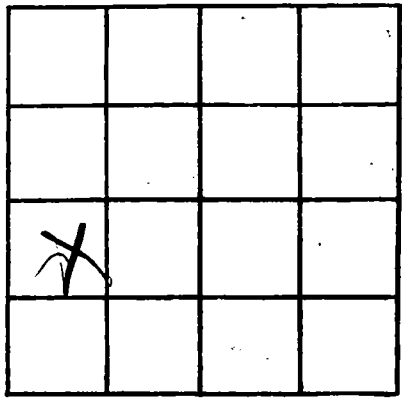

SECTION \_\_\_\_\_

Please indicate well location X.

ADDITIONAL INFORMATION

Multiple horizontal lines for additional information.