

MISSISSIPPI DEPARTMENT OF NATURAL RESOURCES

Bureau of Land and Water Resources

Southport Mall

P.O. Box 10631

Jackson, Mississippi 39209

WATER WELL DRILLERS LOG

Jackson  
H  
2365

11/27/85 1985  
 date well completed

COASTAL DRILLING & SERVICE CORPORATION

RT. 11, BOX 81  
 name of well

county well located

LANDOWNER: Lee O'Neal

BHOXI, MS 39532  
 name of formations encountered

from

to

Hardy 67

top soil

4

5

Baloxi, MS

red clay

5

20

(mailing address)

soft blue clay

20

180

hard blue clay

180

240

good water sand

240

250

WELL LOCATION:

sec. 35 T. 6 N. R. 9 E. S. 10 W.

Hardy 67 miles (distance) of 67 (direction) of 67 (nearest town)

WELL PURPOSE:

home  
 (home, irrigation, municipal, industrial)

WELL COMPLETION DATA:

(1) diameter (inches) 200

(2) total depth (feet) 250

(3) static water level (feet) 10 below 10 above top of ground.

(4) casing PVC (material), 240 (depth)

(size) If telescope see back.

(5) screen 10' (length), 240 (depth to top)

2" (size), PVC (material)

(6) pump 1 (HP), 8 (yield gpm)

CC (type power)

(7) electric log no (yes or no)

(organization running log)

(8) how well bottom plugged 2" back  
with valve


DRILLERS REMARKS:

**RECEIVED**  
 MAY 1 1985

Department of Natural Resources  
 Bureau of Land & Water

If well telescopes please sketch and show depths.

GROUND LEVEL

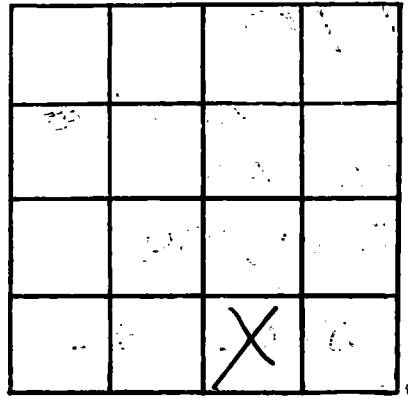

SECTION \_\_\_\_\_

Please indicate well location X.

ADDITIONAL INFORMATION

A series of horizontal lines for writing additional information.

If more than one screen, show locations of each on sketch.