

MISSISSIPPI DEPARTMENT OF NATURAL RESOURCES

Bureau of Land and Water Resources

Southport Mall

P.O. Box 10631

Jackson, Mississippi 39209

WATER WELL DRILLERS LOG
 COASTAL DRILLING & SERVICE CO.

JACKSON
H
2386

12/20/85 19__
 date well completed

RT. 11, BOX 81
 Well name

Harrison
 county well located

BILOXI, MS 39532

LANDOWNER: David White

description of formations encountered	from	to
<u>top soil</u>	<u>1</u>	<u>3</u>
<u>red clay</u>	<u>3</u>	<u>85</u>
<u>hard blue clay</u>	<u>85</u>	<u>170</u>
<u>soft blue clay</u>	<u>170</u>	<u>260</u>
<u>good water sand</u>	<u>260</u>	<u>270</u>

Shaw Rd.


Gulfport, ms
 (mailing address)

WELL LOCATION:

sec. 35 T. 6 N. R. 10 E
 S W
Shaw Rd.
 (distance) miles (direction) of (nearest town)

WELL PURPOSE: home
 (home, irrigation, municipal, industrial)

WELL COMPLETION DATA:

- (1) diameter (Inches) 2"
- (2) total depth (feet) 270
- (3) static water level (feet) 10 
 top of ground.
- (4) casing PVC, 260 below
 (material) (depth)
- (size) If telescope see back.
- (5) screen 10, 260
 (length) (depth to top)
- 2", PVC
 (size) (material)
- (6) pump 1 8
 (HP) (yield gpm)
- etc.
 (type power)
- (7) electric log no
 (yes or no)

(organization running log)

(8) how well bottom plugged 2" back
wash valve


DRILLERS REMARKS:

RECEIVED
 MAY 16 1986

Department of Natural Resources
 Bureau of Land & Water Resources

If well telescopes please sketch and show depths.

GROUND LEVEL

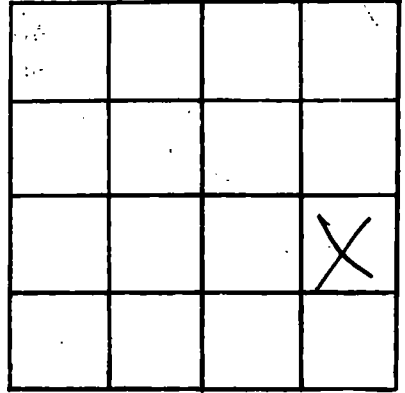

SECTION _____

Please indicate well location X.

ADDITIONAL INFORMATION

If more than one screen,
show locations of each on sketch.