

MISSISSIPPI DEPARTMENT OF NATURAL RESOURCES

Bureau of Land and Water Resources

Southport Mall

P.O. Box 10631

Jackson, Mississippi 39209

WATER WELL DRILLERS LOG

COASTAL DRILLING & SERVICE CO.

Harrison
H
2367

12/16/85 19
date well completed

RT. 611 BOX 81

Harrison
county well located

| LANDOWNER: <u>Ms. Danni Biloxi</u> | Description of formations encountered | from | to |
|---|---------------------------------------|------------|------------|
| <u>Daisy Vester Rd.</u> | | | |
| <u>Biloxi, Mo.</u> (mailing address) | <u>top soil</u> | <u>1</u> | <u>20</u> |
| | <u>red clay</u> | <u>20</u> | <u>185</u> |
| | <u>hard blue clay</u> | <u>185</u> | <u>360</u> |
| | <u>fine water sand</u> | <u>360</u> | <u>370</u> |
| | <u>good water sand</u> | <u>370</u> | <u>380</u> |
| WELL LOCATION: | | | |
| sec. <u>22</u> T. <u>6</u> N. R. <u>9</u> E. S. <u>10</u> W. | | | |
| <u>Biloxi</u> miles (distance) of (direction) of (nearest town) | | | |
| WELL PURPOSE: <u>home</u> (home, irrigation, municipal, industrial) | | | |
| WELL COMPLETION DATA: | | | |
| (1) diameter (inches) <u>2"</u> | | | |
| (2) total depth (feet) <u>380</u> | | | |
| (3) static water level (feet) <u>10'</u> broken top of ground. | | | |
| (4) casing <u>PVC</u> <u>370</u> (material) (depth) | | | |
| <u> </u> if telescope see back. (size) | | | |
| (5) screen <u>10'</u> <u>370</u> (length) (depth to top) | | | |
| <u>2"</u> <u>PVC</u> (size) (material) | | | |
| (6) pump <u>1</u> <u>7</u> (HP) (yield gpm) | | | |
| <u>Etc.</u> (type power) | | | |
| (7) electric log <u>no.</u> (yes or no) | | | |
| <u> </u> (organization running log) | | | |
| (8) how well bottom plugged <u>2" back</u> <u>wash valve.</u> | | | |
| DRILLERS REMARKS: | | | |


RECEIVED

MAY 16 1986

Department of Natural Resources
Bureau of Land & Water Resources

If well telescopes please sketch and show depths.

GROUND LEVEL

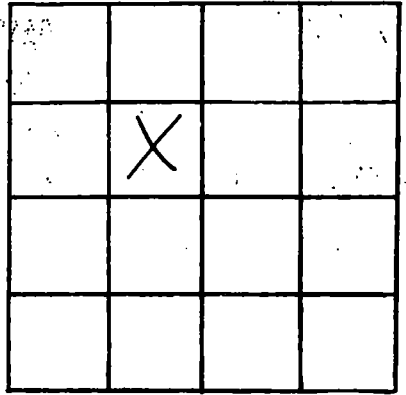

SECTION _____

Please indicate well location X.

ADDITIONAL INFORMATION

If more than one screen,
show locations of each on sketch.