

MISSISSIPPI DEPARTMENT OF NATURAL RESOURCES

Bureau of Land and Water Resources

Southport Mall

P.O. Box 10631

Jackson, Mississippi 39209

WATER WELL DRILLERS LOG

Harrison  
H  
2308

1/11/86 19 1986 COASTAL DRILLING & SERVICE CO. Harrison  
 date well completed well located

LANDOWNER: Samuel Wright RT. 11, BOX 81  
Henry 67 description of formations  
Deloxi, mo BI, 145-90532 from to  
 (mailing address)

WELL LOCATION:  
 sec. 26 T. 6 N. R. 9 E. S. 10 W.  
Henry 67 of Henry 67  
 (distance) (direction) (nearest town)

WELL PURPOSE: home  
 (home, irrigation, municipal, industrial)

WELL COMPLETION DATA:

(1) diameter (inches) 2

(2) total depth (feet) 480

(3) static water level (feet) 10 below  
 top of ground.


(4) casing pvc, 470,  
 (material) (depth)  
 (size) If telescope see back.

(5) screen 10', 470  
 (length) (depth to top)  
2", pvc  
 (size) (material)

(6) pump 1, 8  
 (HP) (yield gpm)  
cl.  
 (type power)

(7) electric log no  
 (yes or no)  
 (organization running log)

(8) how well bottom plugged 2" back  
wash valve,

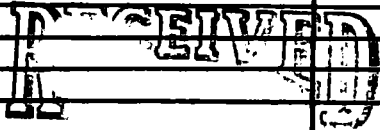

MAY 14 1986

Department of Natural Resources  
 Bureau of Land & Water Resources

DRILLERS REMARKS:

If well telescopes please sketch and show depths.

GROUND LEVEL


SECTION \_\_\_\_\_

Please indicate well location X.

ADDITIONAL INFORMATION

If more than one screen, show locations of each on sketch.