

MISSISSIPPI DEPARTMENT OF NATURAL RESOURCES

Bureau of Land and Water Resources

Southport Mall

P.O. Box 10631

Jackson, Mississippi 39209

WATER WELL DRILLERS LOG
 COASTAL DRILLING & SERVICE CO.

RT. 11, BOX 84

Harrison
 county well located

RIOT MS 39532

HARRISON
 H
 2369

1/10/86 19
 date well completed

LANDOWNER: Jayard Bois
 Johnston still rd.
 Biola, mo
 (mailing address)

description of formations encountered	from	to
red clay	1	25
hard blue clay	25	230
fine water sand	230	455
soft blue clay	455	580
good water sand	580	590

WELL LOCATION:
 sec. 32 T 6 N R 10 E
 S W
 Biola
 (distance) miles (direction) of (nearest town)

WELL PURPOSE: home
 (home, irrigation, municipal, industrial)

WELL COMPLETION DATA:

(1) diameter (Inches) 2"
 (2) total depth (feet) 590
 (3) static water level (feet) 10 below above top of ground.
 (4) casing PVC, 580, (material) (depth)
 (size) If telescope see back.
 (5) screen 10', 580 (length) (depth to top)
 2" PVC (size) (material)
 (6) pump 1, 9 (HP) (yield gpm)
 Elec. (type power)
 (7) electric log no (yes or no)
 (organization running log)
 (8) how well bottom plugged 2" back
 wash valve.


RECEIVED
 MAY 16 1986

Department of Natural Resources
 Bureau of Land & Water Resources

DRILLERS REMARKS:

If well telescopes please sketch and show depths.

GROUND LEVEL

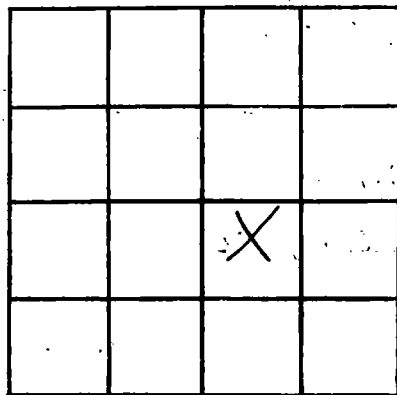

SECTION _____

Please indicate well location X.

ADDITIONAL INFORMATION

If more than one screen, show locations of each on sketch.