

MISSISSIPPI DEPARTMENT OF NATURAL RESOURCES

Bureau of Land and Water Resources

Southport Mall

P.O. Box 10631

Jackson, Mississippi 39209

WATER WELL DRILLERS LOG

COASTAL DRILLING & SERVICE CO.

HARRISON  
H  
2372

1/4/86

date well completed 19

RT. 11, BLOXIE, MS

HARRISON county well located


LANDOWNER: Larry Harrison  
BLOXIE, MS 39532  
Termaine Rd. Mill Creek estate  
Bloxie, MS  
(mailing address)

description of formations encountered	from	to
	top soil	1
red clay	5	210
hard blue clay	210	450
good water sand	450	470

WELL LOCATION:  
sec 28 T 6 N R 10 E  
27 S W  
Bloxie miles of (distance) (direction) (nearest town)

WELL PURPOSE: home  
(home, irrigation, municipal, industrial)

- WELL COMPLETION DATA:
- (1) diameter (inches) 4 x 2
  - (2) total depth (feet) 470
  - (3) static water level (feet) 15 below above top of ground.
  - (4) casing PVC 455 (material) (depth)  
4 x 2 (size) if telescope see back.
  - (5) screen 15 455 (length) (depth to top)  
2" (size) PVC (material)
  - (6) pump 1 9 (HP) (yield gpm)  
Etc (type power)
  - (7) electric log no (yes or no)  
(organization running log)
  - (8) how well bottom plugged 2" back  
wash valves

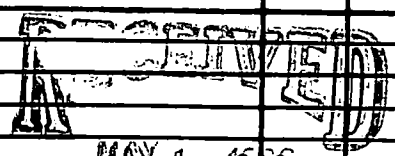

DRILLERS REMARKS:

Department of Natural Resources  
Bureau of Land & Water Resources

If well telescopes please sketch and show depths.


GROUND LEVEL

160' 4" pvc casing

310' 2" pvc casing

15' 2" pvc screen

2" back wash valve

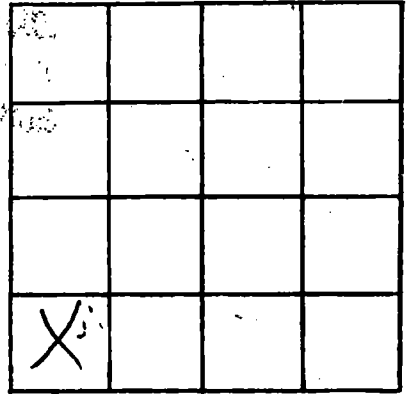

SECTION \_\_\_\_\_

Please indicate well location X.

ADDITIONAL INFORMATION

If more than one screen, show locations of each on sketch.