

HARRISON  
H  
2374

MISSISSIPPI DEPARTMENT OF NATURAL RESOURCES

Bureau of Land and Water Resources

Southport Mall

P.O. Box 10631

Jackson, Mississippi 39209

WATER WELL DRILLERS LOG

COASTAL DRILLING & SERVICE CO. Harrison

1/6/86 19

RT. 11, BOX #81

county well located

LANDOWNER: Gary Tom BLOXIE

description of formations encountered

from to

Hwy. 67

top soil

1 10

Bloxie, ms (mailing address)

red clay

10 165

hard blue clay

165 345

soft blue clay

345 490

good water sand

490 500

WELL LOCATION:

sec. 10 T. 6 N. S. R. 9 E. W.

Hwy. 67 (distance) miles (direction) of (nearest town)

WELL PURPOSE: home (home, irrigation, municipal, industrial)

WELL COMPLETION DATA:

(1) diameter (inches) 4" x 2"

(2) total depth (feet) 500

(3) static water level (feet) 15 (below top of ground)

(4) casing (material) 2" (depth) 485

4" x 2" (size) if telescope see back.

(5) screen (length) 15' (depth to top) 485

2" (size) p.p.c. (material)

(6) pump (HP) (yield gpm)

clc. (type power)

(7) electric log NO. (yes or no)

(organization running log)

(8) how well bottom plugged 3" back wash valve

DRILLERS REMARKS:

RECEIVED

MAY 1 1986

Department of Natural Resources  
Bureau of Land & Water Resources

If well telescopes please sketch and show depths.


GROUND LEVEL

200' 4" pvc casing

300' 2" pvc casing

15' 2" pvc screen

2" pvc back wash valve

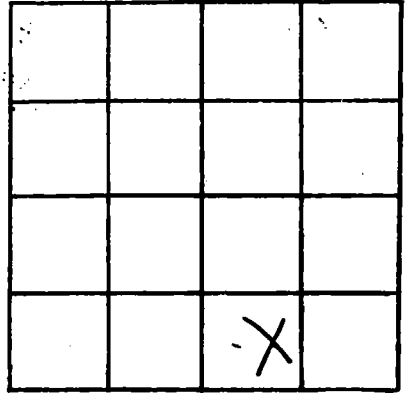

SECTION \_\_\_\_\_

Please indicate well location X.

ADDITIONAL INFORMATION

If more than one screen, show locations of each on sketch.