

MISSISSIPPI DEPARTMENT OF NATURAL RESOURCES

Bureau of Land and Water Resources

Southport Mall

P.O. Box 10631

Jackson, Mississippi 39209

WATER WELL DRILLERS LOG

COASTAL DRILLING & SERVICE CO.

Harrison

Harrison
H
2375

1/27/86 19
date well completed

RT. 44 BOX 81

county well located

LANDOWNER: Low Springs
mill creek cots.
Biloxi, ms.
(mailing address)

description of formations encountered	from	to
top soil	1	10
red clay	10	90
soft blue clay	90	230
hard blue clay	230	390
fine water sand	390	420
coarse water sand	420	430

WELL LOCATION:
sec. 24 T 6 N R 10 E
S W
Biloxi miles (distance) of (direction) (nearest town)

WELL PURPOSE: home
(home, irrigation, municipal, industrial)

WELL COMPLETION DATA:

- (1) diameter (inches) 2'
- (2) total depth (feet) 430
- (3) static water level (feet) 10 below ~~depth~~ top of ground.
- (4) casing PVC (material), 430 (depth),
(size) if telescope see back.
- (5) screen 10' (length), 420 (depth to top),
2" (size), PVC (material)
- (6) pump 1 (HP), 9 (yield gpm),
ELC (type power)
- (7) electric log NO (yes or no)

(organization running log)

(8) how well bottom plugged 2' back
wash valve

DRILLERS REMARKS:


RECEIVED

MAY 19 1986

Department of Natural Resources
Bureau of Land & Water Resources

If well telescopes please sketch and show depths.

GROUND LEVEL

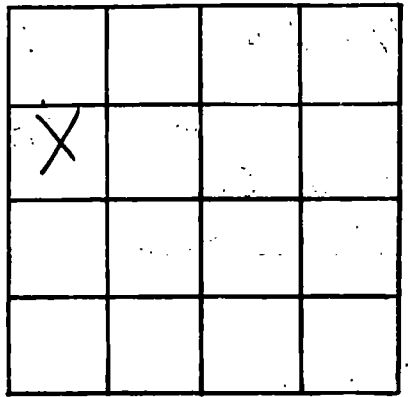

SECTION _____

Please indicate well location X.

ADDITIONAL INFORMATION

If more than one screen,
show locations of each on sketch.