

MISSISSIPPI DEPARTMENT OF NATURAL RESOURCES
Bureau of Land and Water Resources
 Southport Mall
 P.O. Box 10631
 Jackson, Mississippi 39209
WATER WELL DRILLERS LOG

HARRISON
H
2379

2/4/86 19__
 date well completed

COASTAL DRILLING & SERVICE CO. Harrison
 county well located

LANDOWNER: Richard West
Highway 67
Biloxi, MS
 (mailing address)

description of formations	from	to
<u>top soil</u>	<u>1</u>	<u>10</u>
<u>red clay</u>	<u>10</u>	<u>185</u>
<u>soft blue clay</u>	<u>185</u>	<u>360</u>
<u>hard blue clay</u>	<u>360</u>	<u>520</u>
<u>red clay</u>	<u>520</u>	<u>610</u>
<u>fine white sand</u>	<u>610</u>	<u>700</u>
<u>good water sand</u>	<u>700</u>	<u>720</u>

WELL LOCATION:
 sec. 5 T. 6 N. R. 10 E. W. 10
Biloxi miles of _____
 (distance) (direction) (nearest town)


WELL PURPOSE: home
 (home, irrigation, municipal, industrial)

WELL COMPLETION DATA:

- (1) diameter (inches) 4" x 2"
- (2) total depth (feet) 720'
- (3) static water level (feet) 15 below
 top of ground.
- (4) casing PVC, 705'
 (material) (depth)
 (size) If telescope see back.
- (5) screen 15', 705'
 (length) (depth to top)
2", PVC
 (size) (material)
- (6) pump 1, 11
 (HP) (yield gpm)
ELC.
 (type power)
- (7) electric log No
 (yes or no)
 (organization running log)

(8) how well bottom plugged 2" back
wash valve

DRILLERS REMARKS:

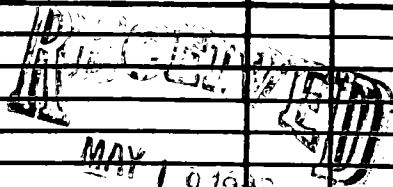

Department of Natural Resources
 Bureau of Land & Water Resources

If well telescopes please sketch and show depths.

GROUND LEVEL

160' 4" PVC casing

X			

SECTION _____

Please indicate well location X.

ADDITIONAL INFORMATION

560' 2" PVC casing

15' 2" PVC screen

2" back wash valve

If more than one screen, show locations of each on sketch.