

MISSISSIPPI DEPARTMENT OF NATURAL RESOURCES

Bureau of Land and Water Resources

Southport Mall

P.O. Box 10631

Jackson, Mississippi 39209

WATER WELL DRILLERS LOG

COSIAL DRILLING & SERVICE CO.

HARRISON  
H  
2380

2/11/86 date well completed 19 81 No. 11, Box 01 Harrison firm name county well located  
BILOXI, MS 39532


LANDOWNER: Jayard Homes  
Jayard Rd.  
Biloxi, ms.  
(mailing address)

description of formations encountered	from	to
<u>top soil</u>	<u>1</u>	<u>10</u>
<u>red clay</u>	<u>10</u>	<u>190</u>
<u>hard blue clay</u>	<u>190</u>	<u>305</u>
<u>good water sand</u>	<u>305</u>	<u>320</u>

WELL LOCATION:  
sec. 34 T. 6 N. R. 10 E  
S W  
Woolmarket  
(distance) (direction) of (nearest town)

WELL PURPOSE: home  
(home, irrigation, municipal, industrial)

- WELL COMPLETION DATA:
- diameter (inches) 4" x 2"
  - total depth (feet) 320
  - static water level (feet) 15 below above top of ground.
  - casing PVC, 305,  
(material) (depth)  
4" x 2" if telescope see back.  
(size)
  - screen 15', 305  
(length) (depth to top)
  - pump 1, 9  
(HP) (yield gpm)  
etc.  
(type power)
  - electric log no  
(yes or no)
- (organization running log)
- (8) how well bottom plugged 2"  
back wash valve

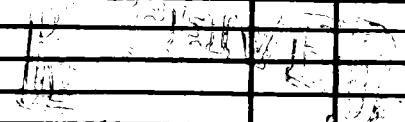

MAY 19 1986


DRILLERS REMARKS:

Department of Natural Resources  
Bureau of Land & Water Resources

If well telescopes please sketch and show depths.

GROUND LEVEL

160' 4" PVC  
Casing

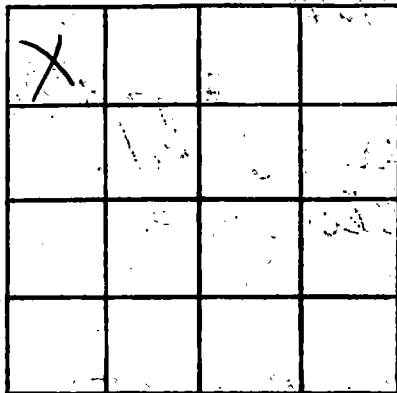

SECTION \_\_\_\_\_

Please indicate well location X.

**ADDITIONAL INFORMATION**

160' 2" PVC  
Casing

15' 5" PVC Screen

2" back wash  
valve.

If more than one screen,  
show locations of each on sketch.