

MISSISSIPPI DEPARTMENT OF NATURAL RESOURCES
Bureau of Land and Water Resources
 Southport Mall
 P.O. Box 10631
 Jackson, Mississippi 39209
WATER WELL DRILLERS LOG

HARRISON
H
2381

2/13/86 19____
 date well completed

COASTAL DRILLING & SERVICE CO (Harrison)

RT. 11, BOX 81

county well located

LANDOWNER: Gulfport Woods, MS 39532
Biloxi, MS
 (mailing address)

depth of formations encountered	from	to
<u>top soil</u>	<u>1</u>	<u>10</u>
<u>red clay</u>	<u>10</u>	<u>116</u>
<u>good water sand</u>	<u>116</u>	<u>126</u>

WELL LOCATION:
 sec. 21 T. 6 N. R. 10 E
 S W
Biloxi
 (distance) (direction) of (nearest town)

WELL PURPOSE: home
 (home, irrigation, municipal, industrial)

- WELL COMPLETION DATA:
- diameter (inches) 2
 - total depth (feet) 126
 - static water level (feet) 10 below above top of ground.
 - casing pvc, 116
 (material) (depth)
 (size) if telescope see back.
 - screen 10', 116
 (length) (depth to top)
2", pvc
 (size) (material)
 - pump 1 9
 (HP) (yield gpm)
elec.
 (type power)
 - electric log no
 (yes or no)
 (organization running log)
 - how well bottom plugged 2" back wash valve

DRILLERS REMARKS:


RECEIVED

MAY 19 1986

Department of Natural Resources
 Bureau of Land & Water Resources

If well telescopes please sketch and show depths.

GROUND LEVEL

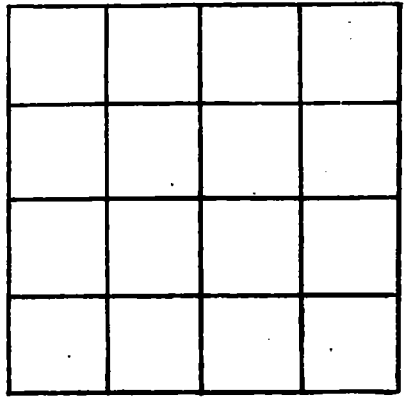

SECTION _____

Please indicate well location X.

ADDITIONAL INFORMATION

A series of horizontal lines for providing additional information, starting below the 'ADDITIONAL INFORMATION' header and extending to the bottom of the page.

If more than one screen, show locations of each on sketch.