

MISSISSIPPI DEPARTMENT OF NATURAL RESOURCES
 Bureau of Land and Water Resources
 Southport Mall
 P.O. Box 10631
 Jackson, Mississippi 39209
WATER WELL DRILLERS LOG

HARRISON
H
2382

2/13/86 19 COASTAL DRILLING & SERVICE CO. Harrison
 date well completed county well located

LANDOWNER: Murray Hester description of formations
Carbridge Rd. to p 500 from 1 to 7
Hulfport, ms. red clay 7 85
 (mailing address) blue clay 85 260
good water sand 260 270

WELL LOCATION:
 sec. 10 T. 6 N. R. 10 E.
 S W
Gulfport of _____
 (distance) in (direction) (nearest town)

WELL PURPOSE: home
 (home, irrigation, municipal, industrial)

- WELL COMPLETION DATA:
- (1) diameter (inches) 2"
 - (2) total depth (feet) 270
 - (3) static water level (feet) 10 below above top of ground.
 - (4) casing pvc, 260,
 (material) (depth)
 (size) If telescope see back.
 - (5) screen 10, 260
 (length) (depth to top)
2', pvc
 (size) (material)
 - (6) pump 1, 8
 (HP) (yield gpm)
Elc
 (type power)
 - (7) electric log no
 (yes or no)

 (organization running log)
 - (8) how well bottom plugged 2" back
wash down


RECEIVED
 MAY 19 1986

DRILLERS REMARKS:

Department of Natural Resources
 Bureau of Land & Water Resources

If well telescopes please sketch and show depths.

GROUND LEVEL

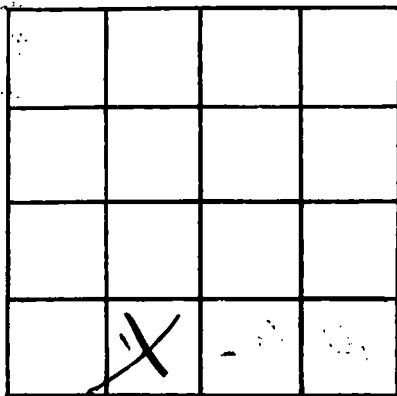

SECTION _____

Please indicate well location X.

ADDITIONAL INFORMATION

If more than one screen,
show locations of each on sketch.