

MISSISSIPPI DEPARTMENT OF NATURAL RESOURCES
Bureau of Land and Water Resources
 Southport Mall
 P.O. Box 10631
 Jackson, Mississippi 39209
WATER WELL DRILLERS LOG

Harrison
H
2383

2/19/86

date well completed

19

COASTAL DRILLING & SERVICE CO.

firm name

Harrison
 county well located

RT. 11 BOX 81

LANDOWNER:

Curtis Holt
WOOLMARKET Rd.

2106 Biloxi, ms.
 (mailing address)

WELL LOCATION:

sec. 3 T. 6 N. R. 10 E.
Woolmarket miles of (direction) of (nearest town)

WELL PURPOSE:

home
 (home, irrigation, municipal, industrial)

WELL COMPLETION DATA:

- (1) diameter (inches) 4" X 2"
- (2) total depth (feet) 350
- (3) static water level (feet) 15 below above top of ground.
- (4) casing PVC 350,
 (material) (depth)
4" X 2"
 (size) if telescope see back.
- (5) screen 15', 335
 (length) (depth to top)
2", PVC
 (size) (material)
- (6) pump 2, 15
 (HP) (yield gpm)
etc.
 (type power)
- (7) electric log no
 (yes or no)

(organization running log)


(8) how well bottom plugged

wash valve, 2" back

DRILLERS REMARKS:

description of formations encountered

	from	to
<u>top soil</u>	<u>1</u>	<u>10</u>
<u>red clay</u>	<u>10</u>	<u>185</u>
<u>soft blue clay</u>	<u>185</u>	<u>250</u>
<u>hard blue clay</u>	<u>250</u>	<u>330</u>
<u>good water sand</u>	<u>330</u>	<u>350</u>

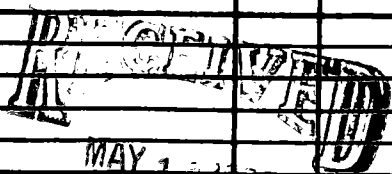

Department of Natural Resources
 Bureau of Land & Water Resources

If well telescopes please sketch and show depths.


GROUND LEVEL

200' 4" pvc casing

15' 2" pvc casing

15' 2" pvc screen
2" back wash valve

If more than one screen, show locations of each on sketch.

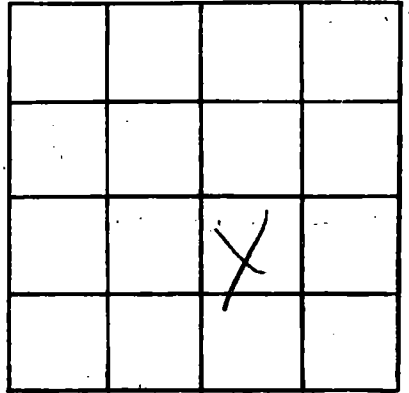

SECTION _____

Please indicate well location X.

ADDITIONAL INFORMATION

Multiple horizontal lines for additional information.