

**MISSISSIPPI DEPARTMENT OF NATURAL RESOURCES**  
**Bureau of Land and Water Resources**  
 Southport Mall  
 P.O. Box 10631  
 Jackson, Mississippi 39209  
**WATER WELL DRILLERS LOG**

HARRISON  
H  
2384

2/22/80 19\_\_  
 date well completed

COASTAL DRILLING & SERVICE CO.

Harrison  
 county well located

LANDOWNER: Jim Stacham  
Hwy 67  
Baloxi, Mo  
 (mailing address)

RT. 11, BOX 01  
BALOXI, MS 39532

description of formations encountered	from	to
<u>top soil</u>	<u>1</u>	<u>5</u>
<u>red clay</u>	<u>5</u>	<u>170</u>
<u>blue clay</u>	<u>170</u>	<u>300</u>
<u>good water sand</u>	<u>300</u>	<u>310</u>

WELL LOCATION:  
 sec. 35 T. 6 N. R. 10  
S E  
Baloxi  
 (distance) (direction) (nearest town)


WELL PURPOSE: home  
 (home, irrigation, municipal, industrial)

- WELL COMPLETION DATA:
- diameter (inches) 2"
  - total depth (feet) 310
  - static water level (feet) 10 below  
 top of ground.
  - casing pvc, 300  
 (material) (depth)  
 (size) if telescope see back.
  - screen 10', 300  
 (length) (depth to top)  
2", pvc  
 (size) (material)
  - pump 1, 8  
 (HP) (yield gpm)  
Elc  
 (type power)
  - electric log no  
 (yes or no)

(organization running log)

(8) how well bottom plugged 2" back  
wash down

DRILLERS REMARKS: \_\_\_\_\_

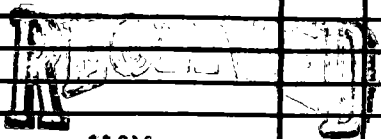

MAY 19 1980

Department of Natural Resources  
 Bureau of Land & Water Resources

If well telescopes please sketch and show depths.

GROUND LEVEL


SECTION \_\_\_\_\_

Please indicate well location X.

ADDITIONAL INFORMATION

If more than one screen, show locations of each on sketch.