

MISSISSIPPI DEPARTMENT OF NATURAL RESOURCES

Bureau of Land and Water Resources

Southport Mall

P.O. Box 10631

Jackson, Mississippi 39209

WATER WELL DRILLERS LOG

Harrison
H
2385

2-28-86 19 Coast Water Well Dr. Harrison
 date well completed firm name county well located

LANDOWNER: Richard King

description of formations encountered

from

to

7420 Fountainbleau Rd

Rd

Ocean Springs ms
 (mailing address) 39564

Top Soil

0

5

WELL LOCATION:

sec. 35 T. 6 S. R. 10 W.
3 miles East of Woodmark
 (distance) (direction) (nearest town)

Red Clay

5

20

Blue Clay

20

400

Blue Fine Sand

400

430

WELL PURPOSE: Home
 (home, irrigation, municipal, industrial)

Gray med. Sand

430

450

WELL COMPLETION DATA:

Gray Coarse Sand

450

488

(1) diameter (inches) 2"

Gray Coarse Sand + Gravel

488

495

(2) total depth (feet) 495

(3) static water level (feet) 42 below above top of ground.

(4) casing PVC, 470'
 (material) (depth)

2" If telescope see back.
 (size)

(5) screen 20', 470'
 (length) (depth to top)

2", PVC
 (size) (material)

(6) pump 1hp, 9
 (HP) (yield gpm)

Elec
 (type power)

(7) electric log no
 (yes or no)

(organization running log)

(8) how well bottom plugged? Backwash valve

DRILLERS REMARKS:


5' 2" tailpipe

RECEIVED
 MAY 12 1986

Department of Natural Resources
 Bureau of Land & Water Resources

If well telescopes please sketch and show depths.

GROUND LEVEL

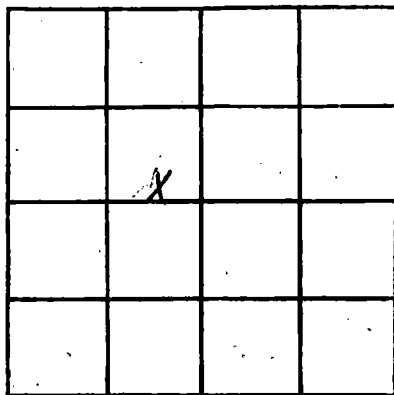

SECTION 35

Please indicate well location X.

ADDITIONAL INFORMATION

If more than one screen, show locations of each on sketch.