

MISSISSIPPI DEPARTMENT OF NATURAL RESOURCES

Bureau of Land and Water Resources

Southport Mall

P.O. Box 10631

Jackson, Mississippi 39209

WATER WELL DRILLERS LOG

COASTAL DRILLING & SERVICE CO.

HARRISON  
H  
2389

3/10/86

date well completed

19

RT. 11, BOX 81

Harrison

county well located

LANDOWNER: Monty Dawls

Woolmarket Rd.

Biloxi, Ms

(mailing address)

WELL LOCATION:

sec. 4 T. 6 N. R. 10 E.  
S W

Woolmarket Rd.

(distance) (direction) (nearest town)

WELL PURPOSE:

(home, irrigation, municipal, industrial)

WELL COMPLETION DATA:

- (1) diameter (inches) 2"
- (2) total depth (feet) 502
- (3) static water level (feet) 190 below above top of ground.
- (4) casing pvc 498 (material) (depth)

(size) if telescope see back.

- (5) screen 10' 498 (length) (depth to top)

2" pvc (size) (material)

- (6) pump 1 9 (HP) (yield gpm)

Clear (type power)

- (7) electric log no (yes or no)

(organization running log)

- (8) how well bottom plugged 2" back wash valve

description of formations encountered	from	to
	top soil	1
red clay	10	190
soft blue clay	190	360
hard blue clay	360	498
good water sand	498	502

RECEIVED


MAY 10 1986

DRILLERS REMARKS:

Department of Natural Resources  
Bureau of Land & Water Resources

If well telescopes please sketch and show depths.

GROUND LEVEL

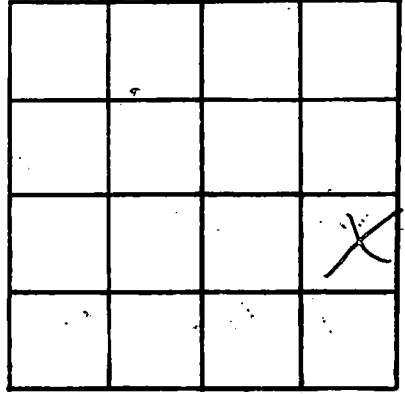

SECTION \_\_\_\_\_

Please indicate well location X.

ADDITIONAL INFORMATION

If more than one screen, show locations of each on sketch.