

MISSISSIPPI DEPARTMENT OF NATURAL RESOURCES

Bureau of Land and Water Resources

Southport Mall

P.O. Box 10631

Jackson, Mississippi 39209

WATER WELL DRILLERS LOG

HARRISON
H
2370

3/15/86

date well completed

19 RT. 11, BOX 87 firm name

BILOXI, MS 39530

Harrison county well located

LANDOWNER:

Henry [unclear]

Description of formations encountered

from

to

Hwy 15

top soil

1 10

red clay

10 60

soft blue clay

60 260

hard blue clay

260 240

good water sand

240 260

Biloxi ms

(mailing address)

WELL LOCATION:

sec. 32 T. 6 N R. 9 E S W

Biloxi

(distance) (direction) (nearest town)

WELL PURPOSE:

home (home, irrigation, municipal, industrial)

WELL COMPLETION DATA:

- (1) diameter (inches) 4 x 2
- (2) total depth (feet) 260
- (3) static water level (feet) 15 below top of ground.

(4) casing PVC, 245 (material) (depth)

4 x 2 (size) if telescope see back.

(5) screen 15', 245 (length) (depth to top)

2" PVC (size) (material)


(6) pump 1 (HP) 9 (yield gpm)

etc. (type power)

(7) electric log no (yes or no)

(organization running log)

(8) how well bottom plugged 2" back wash valve

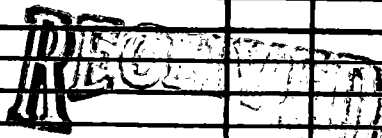

MAY 19 1986


Department of Natural Resources Bureau of Land & Water Resources

DRILLERS REMARKS:

If well telescopes please sketch and show depths.

GROUND LEVEL

160' 4" pvc casing

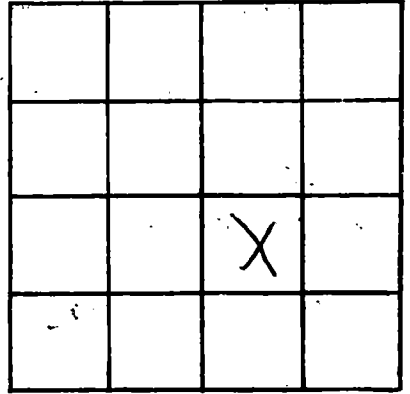

SECTION _____

Please indicate well location X.

ADDITIONAL INFORMATION

100' 2" pvc casing

15' 2" pvc screen

2" Back wash valve

If more than one screen, show locations of each on sketch.