

MISSISSIPPI DEPARTMENT OF NATURAL RESOURCES

Bureau of Land and Water Resources

Southport Mall

P.O. Box 10631

Jackson, Mississippi 39209

WATER WELL DRILLERS LOG

HARRISON  
#  
2378

3-25-86 19 COAST WATER WELL SIC HARRISON  
 date well completed firm name county well located

LANDOWNER: SAMMY HANDLE  
Rt. 5 Box 73 Lot 184  
Biloxi, MS 39532  
 (mailing address)

Description of formations encountered	from	to
TOP SOIL	0	1
BROWN CLAY	1	8
GRAVEL + SHELL	8	14
BROWN CLAY	14	70
BLUE CLAY	70	283
MED GRAY SAND	283	335
BLUE CLAY	335	340

WELL LOCATION:  
 sec. 36 T. 6 N. R. 10 E.  
4 miles NORTH of Biloxi  
 (distance) (direction) (nearest town)

WELL PURPOSE: HOME  
 (home, irrigation, municipal, industrial)

WELL COMPLETION DATA:

(1) diameter (inches) 2"

(2) total depth (feet) 340'

(3) static water level (feet) 35 below top of ground.

(4) casing PVC, 325'  
 (material) (depth)  
2" If telescope see back.  
 (size)


(5) screen 70, 325'  
 (length) (depth to top)  
2", PVC  
 (size) (material)

(6) pump 1hp, 9  
 (HP) (yield gpm)  
Electric  
 (type power)

(7) electric log no  
 (yes or no)

(organization running log)

(8) how well bottom plugged BACKWASH VALVE

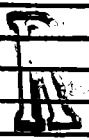


MAY 12 1986

Department of Natural Resources  
 Bureau of Land & Water Resources

DRILLERS REMARKS: 5' - 2" PVC TAILPIPE

If well telescopes please sketch and show depths.

GROUND LEVEL

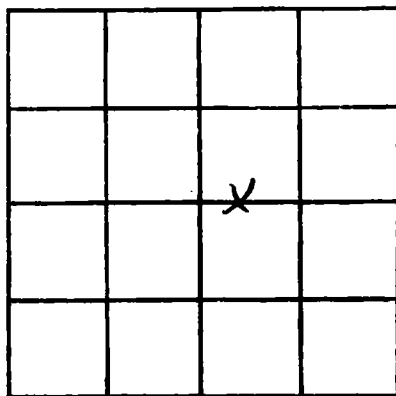

SECTION 36

Please indicate well location X.

ADDITIONAL INFORMATION

If more than one screen, show locations of each on sketch.