

MISSISSIPPI DEPARTMENT OF NATURAL RESOURCES
Bureau of Land and Water Resources
 Southport Mall
 P.O. Box 10631
 Jackson, Mississippi 39209
WATER WELL DRILLERS LOG

HARRISON
H
2395

4/18/80 19____
 date well completed

COASTAL DRILLING & SERVICE CO.
 firm name

Harrison
 county well located

RT. 11, BOX 81
 address

LANDOWNER: Ann Santa Cruz
Biloxi, MS

description of formations
 encountered

from to

Woolmarket Lot 42

top soil

1 10

Biloxi, ms
 (mailing address)

red clay

10 240

soft blue clay

240 460

good water sand

460 480

WELL LOCATION:

sec. 4 T. 6 N. R. 10 E.
 S W

Woolmarket miles of W (direction) of (nearest town)

WELL PURPOSE: home
 (home, irrigation, municipal, industrial)

WELL COMPLETION DATA:

- (1) diameter (inches) 2"
 (2) total depth (feet) 480
 (3) static water level (feet) 10 below above
 top of ground.

(4) casing PVC 470
 (material) (depth)

(size) If telescope see back.

(5) screen 10 470
 (length) (depth to top)

(size) PVC
 (material)

(6) pump 1 9
 (HP) (yield gpm)

etc
 (type power)

(7) electric log no
 (yes or no)

(organization running log)

(8) how well bottom plugged 2" back
wash valve

DRILLERS REMARKS:


RECEIVED
RECEIVED

MAY 7 9 1980

Department of Natural Resources
 Bureau of Land & Water Resources

If well telescopes please sketch and show depths.

GROUND LEVEL

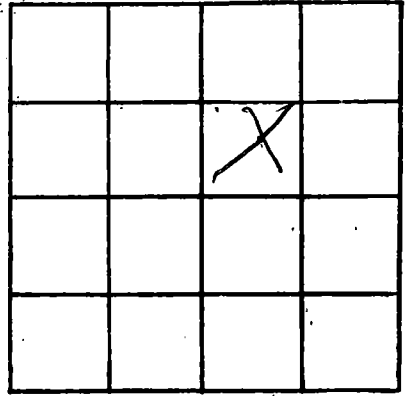

SECTION _____

Please indicate well location X.

ADDITIONAL INFORMATION

If more than one screen,
show locations of each on sketch.