

MISSISSIPPI DEPARTMENT OF NATURAL RESOURCES

Bureau of Land and Water Resources

Southport Mall

P.O. Box 10631

Jackson, Mississippi 39209

WATER WELL DRILLERS LOG

COASTAL DRILLING & SERVICE CO.

RT. 11, BOX 81

county well located

HARRISON  
H  
2399

4/18/86  
date well completed

Harrison

LANDOWNER: J.O. McMillan

description of formations encountered	39532	
	from	to
top soil	1	10
red clay	10	220
good white sand	220	240

Hwy 67

Beloxi, MS  
(mailing address)

WELL LOCATION:

sec. 35 T. 6 N. R. 10 E. S. W.

(distance) miles (direction) of (nearest town)

WELL PURPOSE: home  
(home, irrigation, municipal, industrial)

WELL COMPLETION DATA:

- (1) diameter (inches) 2"
- (2) total depth (feet) 240
- (3) static water level (feet) 10 below top of ground.

(4) casing pvc 230 (material) (depth)  
(size) If telescope see back.

(5) screen 10' 230 (length) (depth to top)  
2" (size) pvc (material)

(6) pump 1 11 (HP) (yield gpm)  
etc. (type power)

(7) electric log no (yes or no)

(organization running log)

(8) how well bottom plugged 2" back wash gravel

DRILLERS REMARKS:


RECEIVED

JUN 18 1986

Department of Natural Resources  
Bureau of Land & Water Resources

If well telescopes please sketch and show depths.

GROUND LEVEL

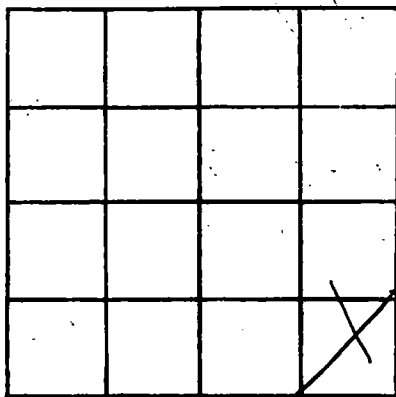

SECTION \_\_\_\_\_

Please indicate well location X.

ADDITIONAL INFORMATION

If more than one screen,  
show locations of each on sketch.