

MISSISSIPPI DEPARTMENT OF NATURAL RESOURCES

Bureau of Land and Water Resources

Southport Mall

P.O. Box 10631

Jackson, Mississippi 39209

WATER WELL DRILLERS LOG *HARRISON*

HARRISON  
H  
2401

4-29-86 19 Coast Water Well JACKSON  
 date well completed firm name county well located

LANDOWNER: Bruce Scott  
318 CJ Dellie Rt 2  
Saucier ms 39574  
 (mailing address)

WELL LOCATION:  
 sec. 18 T. 6 N. R. 9 E.  
5 miles NW of DIBERVILLE  
 (distance) (direction) (nearest town)

WELL PURPOSE: home  
 (home, irrigation, municipal, industrial)

WELL COMPLETION DATA:

(1) diameter (Inches) 2"

(2) total depth (feet) 259'

(3) static water level (feet) 39' below above top of ground.

(4) casing PVC, 244'  
 (material) (depth)  
2" If telescope see back.  
 (size)

(5) screen 10', 244'  
 (length) (depth to top)  
2" PVC  
 (size) (material)

(6) pump \_\_\_\_\_  
 (HP) (yield gpm)  
 \_\_\_\_\_  
 (type power)

(7) electric log no  
 (yes or no)  
 \_\_\_\_\_  
 (organization running log)

(8) how well bottom plugged backwash valve

description of formations encountered	from to	
Top Soil	0	1
Red Clay	1	19
Red med sand	19	31
Blue clay	31	214
Blue Clay and streak of sand	214	223
Gray coarse sand	223	254
Blue clay	254	259

**RECEIVED**


JUL 1 8 1986

Department of Natural Resources  
 Bureau of Land & Water Resources

DRILLERS REMARKS:  
31' - 2" PVC tailpipe

If well telescopes please sketch and show depths.

GROUND LEVEL

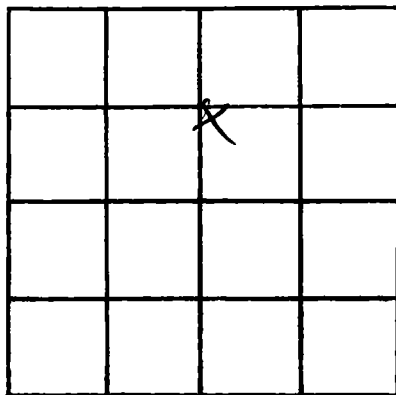

SECTION 18

Please indicate well location X.

ADDITIONAL INFORMATION

If more than one screen,  
show locations of each on sketch.