

MISSISSIPPI DEPARTMENT OF NATURAL RESOURCES

Bureau of Land and Water Resources

Southport Mall

P.O. Box 10631

Jackson, Mississippi 39209

WATER WELL DRILLERS LOG

HARRISON
H
2402

June 9-1986 19 Matt Pump Wells Harrison
 date well completed firm name county well located

LANDOWNER: Claud Heris
Box 6175 N. Branch
Biloxi Ms 39532
 (mailing address)

description of formations encountered	depth	
	from	to
<u>Mud</u>	<u>0</u>	<u>10</u>
<u>Sand</u>	<u>10</u>	<u>30</u>
<u>Mud</u>	<u>30</u>	<u>410</u>
<u>Sand</u>	<u>410</u>	<u>460</u>

WELL LOCATION:
 sec. 35 T. 6 N R. 10 E
4 miles East of Waubesa
 (distance) (direction) (nearest town)

WELL PURPOSE: home
 (home, irrigation, municipal, industrial)

- WELL COMPLETION DATA:
- (1) diameter (inches) 2"
 - (2) total depth (feet) 460'
 - (3) static water level (feet) 40' ^{below} _{above} top of ground
 - (4) casing PVC 450
 (material) (depth)
2"
 (size) if telescope see back.
 - (5) screen 10' Bottom
 (length) (depth to top)
2" PVC
 (size) (material)
 - (6) pump 1 10
 (HP) (yield gpm)
electric
 (type power)
 - (7) electric log no
 (yes or no)
- (organization running log)
- (8) how well bottom plugged Seal

RECEIVED


AUG 7 1986

Department of Natural Resources
 Bureau of Land & Water Resources

DRILLERS REMARKS:

If well telescopes please sketch and show depths.

GROUND LEVEL

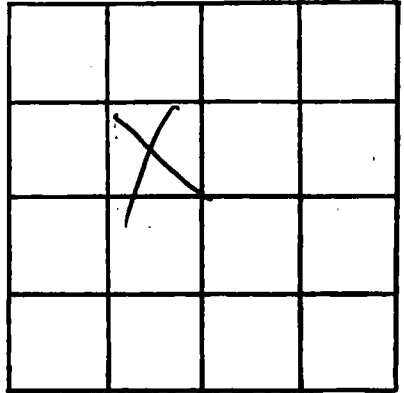

SECTION _____

Please indicate well location X.

ADDITIONAL INFORMATION

If more than one screen, show locations of each on sketch.