

MISSISSIPPI DEPARTMENT OF NATURAL RESOURCES

Bureau of Land and Water Resources

Southport Mall

P.O. Box 10631

Jackson, Mississippi 39209

WATER WELL DRILLERS LOG

COASTAL DRILLING & SERVICE CO.

Harrison
H
2405

5/5/86 19
 date well completed

RT. 1, BOX 81
 RT. #, BOX #

Harrison
 county well located

LANDOWNER: Ed Seitz
RT. 1 Box 243
Biloxi, MS
 (mailing address)

BIL MS 39532
 description of formations encountered

| description of formations encountered | from | to |
|---------------------------------------|------------|------------|
| <u>top soil</u> | <u>1</u> | <u>5</u> |
| <u>red clay</u> | <u>5</u> | <u>110</u> |
| <u>good water sand</u> | <u>110</u> | <u>130</u> |

WELL LOCATION:
sec. 33 T 6 N R 10 E
W
Woodmark
1 miles (distance) of (direction) of (nearest town)

WELL PURPOSE: home
 (home, irrigation, municipal, industrial)

- WELL COMPLETION DATA:
- (1) diameter (inches) 2"
 - (2) total depth (feet) 130'
 - (3) static water level (feet) 10 below top of ground.
 - (4) casing PVC, 120,
 (material) (depth)
 (size) if telescope see back.
 - (5) screen 10', 120
 (length) (depth to top)
2", PVC
 (size) (material)
 - (6) pump 1, 8
 (HP) (yield gpm)
etc.
 (type power)
 - (7) electric log no.
 (yes or no)
 (organization running log)
 - (8) how well bottom plugged 2" back
WASH VALVE

RECEIVED


AUG 10 1986

DRILLERS REMARKS:

Department of Natural Resources
 Bureau of Land & Water Resources

If well telescopes please sketch and show depths.

GROUND LEVEL

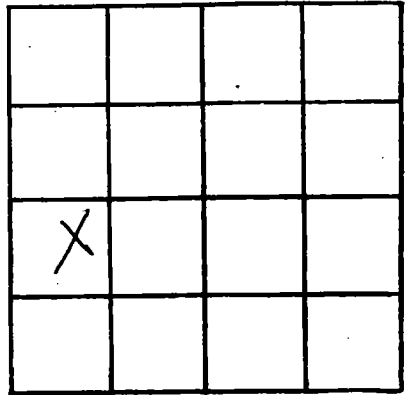

SECTION _____

Please indicate well location X.

ADDITIONAL INFORMATION

If more than one screen, show locations of each on sketch.