

MISSISSIPPI DEPARTMENT OF NATURAL RESOURCES

Bureau of Land and Water Resources

Southport Mall

P.O. Box 10631

Jackson, Mississippi 39209

WATER WELL DRILLERS LOG

COASTAL DRILLING & SERVICE CO.

Harrison
H
2408

5/9/86 date well completed 19 RT. 11, BOX 04 firm name Harrison county well located

LANDOWNER: Walter Manselle Biloxi, MS 39522 description of formations encountered from to

<u>Hwy B</u>	<u>top soil</u>	<u>1</u>	<u>5</u>
<u>Biloxi, MS</u>	<u>red clay</u>	<u>5</u>	<u>100</u>
(mailing address)	<u>blue clay</u>	<u>100</u>	<u>205</u>
	<u>fine water sand</u>	<u>205</u>	<u>215</u>
	<u>coarse water sand</u>	<u>215</u>	<u>230</u>

WELL LOCATION: sec 29 T 6 N S R 9 E W
Biloxi miles of (distance) (direction) of (nearest town)

WELL PURPOSE: home
 (home, irrigation, municipal, industrial)

WELL COMPLETION DATA:

(1) diameter (inches) 2"

(2) total depth (feet) 230

(3) static water level (feet) 10 below above top of ground.

(4) casing PVC, 220,
 (material) (depth)
 (size) If telescope see back.

(5) screen 10', 220
 (length) (depth to top)
2", PVC
 (size) (material)

(6) pump 1 11
 (HP) (yield gpm)
etc.
 (type power)

(7) electric log no.
 (yes or no)
 (organization running log)

(8) how well bottom plugged 2" back
wash valve.

RECEIVED


AUG 19 1986

Department of Natural Resources
 Bureau of Land & Water Resources

DRILLERS REMARKS:

If well telescopes please sketch and show depths.

GROUND LEVEL

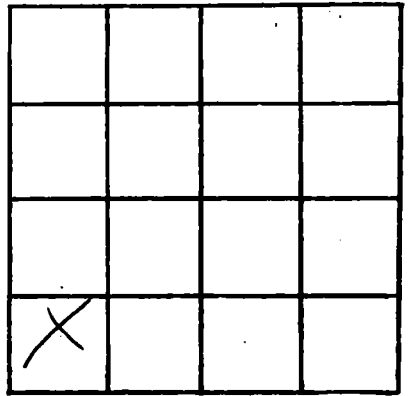

SECTION _____

Please indicate well location X.

ADDITIONAL INFORMATION

If more than one screen, show locations of each on sketch.