

**MISSISSIPPI DEPARTMENT OF NATURAL RESOURCES**  
 Bureau of Land and Water Resources  
 Southport Mall  
 P.O. Box 10631  
 Jackson, Mississippi 39209  
**WATER WELL DRILLERS LOG**

HARRISON  
H  
2409

**COASTAL DRILLING & SERVICE**  
 RT. 11<sup>th</sup> BOX 81  
 Harrison  
 County well located

5/13/86 19  
 date well completed

LANDOWNER: Charlie W. Harrison  
7201 Kruger Rd.  
Biloxi, MS  
 (mailing address)


description of formations encountered	from	to
top soil	1	10
red clay	10	105
hard white clay	105	230
good water sand	230	240

WELL LOCATION:  
 sec. 9 T. 6 N. R. 10 E  
                   S                                  W  
 \_\_\_\_\_ miles \_\_\_\_\_ of \_\_\_\_\_  
 (distance) (direction) (nearest town)

WELL PURPOSE: home  
 (home, irrigation, municipal, industrial)

**WELL COMPLETION DATA:**

- (1) diameter (inches) 2"
- (2) total depth (feet) 240
- (3) static water level (feet) 210 below above top of ground.
- (4) casing PVC, 230,  
 (material) (depth)
- \_\_\_\_\_ If telescope see back.  
 (size)
- (5) screen 10', 230  
 (length) (depth to top)
- 2", PVC  
 (size) (material)
- (6) pump 1 8  
 (HP) (yield gpm)
- ELC  
 (type power)
- (7) electric log no  
 (yes or no)

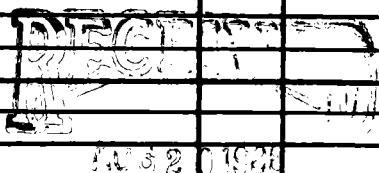

\_\_\_\_\_ (organization running log)


(8) how well bottom plugged 2" back wash valve.

Department of Natural Resources  
 Bureau of Land & Water Resources

DRILLERS REMARKS: \_\_\_\_\_

If well telescopes please sketch and show depths.

**GROUND LEVEL**

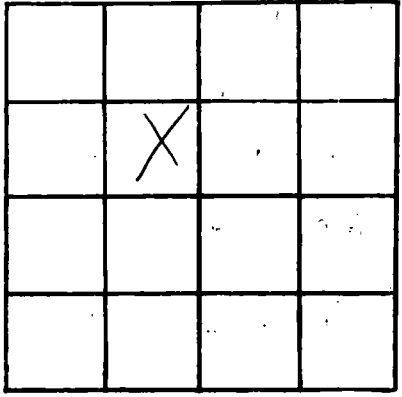

**SECTION** \_\_\_\_\_

Please indicate well location X.

**ADDITIONAL INFORMATION**

---

---

If more than one screen, show locations of each on sketch.