

MISSISSIPPI DEPARTMENT OF NATURAL RESOURCES

Bureau of Land and Water Resources

Southport Mall

P.O. Box 10631

Jackson, Mississippi 39209

WATER WELL DRILLERS LOG

HARRISON  
H  
2410

COASTAL DRILLING & SERVICE-HARRISON

RT. 17, BOX 81

county well located

5/16/86 19  
date well completed

LANDOWNER: C. Centefora	DEPT. OF NATURAL RESOURCES FORMATION NO. 39532	from	to
9005 Daisy Vester Rd.	top soil	1	10
Biloxi, MS 39532 (mailing address)	red clay	10	180
	hard blue clay	180	250
	fine water sand	250	260
	good water sand	260	270

WELL LOCATION:

sec. 32 T 6 N S R 9 E W  
off Hwy 415  
(distance) miles (direction) of (nearest town)

WELL PURPOSE: home  
(home, irrigation, municipal, industrial)

WELL COMPLETION DATA:

- (1) diameter (inches) 2"
- (2) total depth (feet) 270
- (3) static water level (feet) 10" below above top of ground.
- (4) casing PVC, 260'  
(material) (depth)
- (size) If telescope see back.
- (5) screen 10', 260'  
(length) (depth to top)
- 2', PVC  
(size) (material)
- (6) pump 1 (HP) 7 (yield gpm)
- flc.  
(type power)
- (7) electric log no  
(yes or no)

(organization running log)

(8) how well bottom plugged 2' back  
WASH VALVES

DRILLERS REMARKS:


RECEIVED

AUG 19 1986

Department of Natural Resources  
Bureau of Land & Water Resources

If well telescopes please sketch and show depths.

GROUND LEVEL

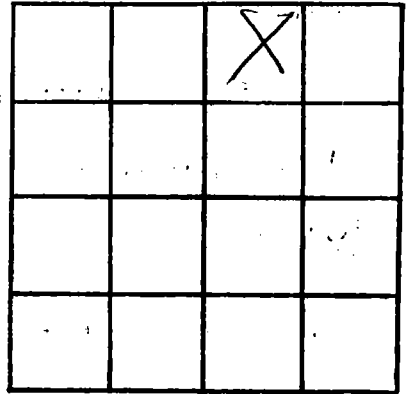

SECTION \_\_\_\_\_

Please indicate well location X.

ADDITIONAL INFORMATION

If more than one screen,  
show locations of each on sketch.