

MISSISSIPPI DEPARTMENT OF NATURAL RESOURCES

Bureau of Land and Water Resources

Southport Mall

P.O. Box 10631

Jackson, Mississippi 39209

WATER WELL DRILLERS LOG

COASTAL DRILLING & SERVICE CO.

RT. 11 BOX 01

county well located

BILOXI, MS 39532

HARRISSU  
H  
2411

6/5/86 19  
date well completed

LANDOWNER: Herbert Lloyd

Rt. 3 Box 243-A

Biloxi, MS  
(mailing address)

WELL LOCATION:  
sec 28 T 6 N S R 10 E W

miles of  
(distance) (direction) (nearest town)

WELL PURPOSE: home  
(home, irrigation, municipal, industrial)

WELL COMPLETION DATA:

- (1) diameter (inches) 4" x 2"
- (2) total depth (feet) 460'
- (3) static water level (feet) 15' below top of ground.
- (4) casing PVC, 445' (material) (depth)
- 4" x 2" if telescope see back.
- (5) screen 15' 445' (length) (depth to top)
- 2" PVC (size) (material)
- (6) pump 1 12 (HP) (yield gpm)
- PVC (type power)
- (7) electric log NO (yes or no)
- (organization running log)
- (8) how well bottom plugged 2' back wash valve

description of formations encountered

description of formations encountered	from	to
top soil	1	3
soft blue clay	3	75
chka blue clay	75	180
fine water sand	180	200
hard clay	200	310
hard blue clay	310	430
good water sand	430	445

RECEIVED

AUG 20 1986

Department of Natural Resources  
Bureau of Land & Water Resources

DRILLERS REMARKS:

If well telescopes please sketch and show depths.

GROUND LEVEL


160' 4" pvc casing

300' 2" pvc casing

10' 2" pvc casing

2" BACK WASH

VALVE

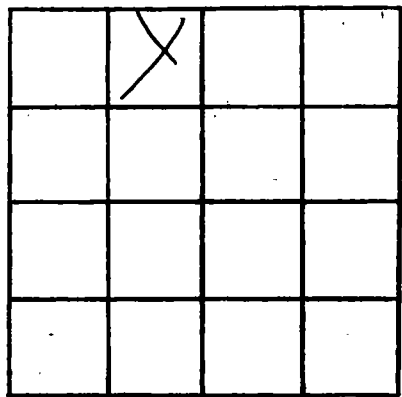

SECTION \_\_\_\_\_

Please indicate well location X.

ADDITIONAL INFORMATION

If more than one screen, show locations of each on sketch.