

MISSISSIPPI DEPARTMENT OF NATURAL RESOURCES

Bureau of Land and Water Resources

Southport Mall

P.O. Box 10631

Jackson, Mississippi 39209

WATER WELL DRILLERS LOG

COASTAL DRILLING & SERVICE CO.

HARRISON
H
24/12

6/6/56 19
date well completed

RT. 11, BOX 81
BILOXI, MS 39532

Harrison
county well located

LANDOWNER: Hwy 67, Gro.
Hwy 67.
Biloxi, MS
(mailing address)

description of formations encountered	from	to
top soil	1	3
red clay	3	150
soft blue clay	150	245
hard blue clay	245	325
good water sand	325	345

WELL LOCATION:
sec. 35 T 6 N S R 10 E W
_____ miles _____ of _____
(distance) (direction) (nearest town)

WELL PURPOSE: home
(home, irrigation, municipal, industrial)

- WELL COMPLETION DATA:
- (1) diameter (inches) 4" x 2"
 - (2) total depth (feet) 345
 - (3) static water level (feet) 15 below top of ground.
 - (4) casing PVC, 330, (material), (depth), 4" x 2" (size) If telescope see back.
 - (5) screen 15', 330 (length), (depth to top), 2", PVC (size), (material)
 - (6) pump 1 (HP), 10 (yield gpm), Elk (type power)
 - (7) electric log NO (yes or no)
 - (organization running log)
 - (8) how well bottom plugged 2" back wash valve.

RECEIVED

AUG 20 1956


Department of Natural Resources
Bureau of Land & Water Resources

DRILLERS REMARKS:

If well telescopes please sketch and show depths.

GROUND LEVEL

150' 4" pvc casing

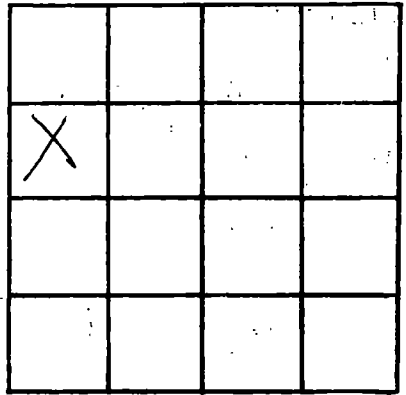

SECTION _____

Please indicate well location X.

ADDITIONAL INFORMATION

165' 2" pvc casing

15' 2" pvc screen

2" back wash valve

If more than one screen, show locations of each on sketch.