

MISSISSIPPI DEPARTMENT OF NATURAL RESOURCES

Bureau of Land and Water Resources

Southport Mall

P.O. Box 10631

Jackson, Mississippi 39209

COASTAL DELTAIC & BERMUDESE LOG

RT. 11, BOX 81

BILOXI, MS 39532

Harrison

county well located

HARRISON
H
2414

6/16/86 19
date well completed

LANDOWNER: James Cook
Sorraine Rd.
Biloxi, MS
(mailing address)

description of formations encountered	from to	
top soil	1	10
red clay	10	280
sext. laked clay	280	475
good water sand	475	495

WELL LOCATION:
sec. 7 T. 6 N. R. 10 E
S W
miles (distance) of (direction) of (nearest town)

WELL PURPOSE: home
(home, irrigation, municipal, industrial)

WELL COMPLETION DATA:
(1) diameter (inches) 2"
(2) total depth (feet) 495
(3) static water level (feet) 10 below top of ground.
(4) casing PVC 485 (material), (depth)
(size) If telescope see back.
(5) screen 10' 485 (length), (depth to top)
2" PVC (size), (material)
(6) pump 1 (HP), 11 (yield gpm)
9kw (type power)
(7) electric log no (yes or no)
(organization running log)
(8) how well bottom plugged 2" back wash valve.


REC AUG 1 2 1986

Department of Natural Resources
Bureau of Land & Water Resources

DRILLERS REMARKS:

If well telescopes please sketch and show depths.

GROUND LEVEL

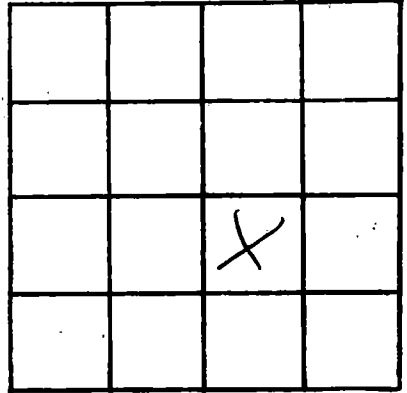

SECTION _____

Please indicate well location X.

ADDITIONAL INFORMATION

If more than one screen,
show locations of each on sketch.