

MISSISSIPPI DEPARTMENT OF NATURAL RESOURCES

Bureau of Land and Water Resources

Southport Mall

P.O. Box 10631

Jackson, Mississippi 39209

COASTAL WATER WELL DRILLERS LOG

RT. 11, BOX 84

BILOXI, MS 39532

Harrison
Harrison

Harrison
H
2415

6/16/86 19
date well completed

LANDOWNER: Steve Palmer

old woodmasted

Bubri, MS
(mailing address)

WELL LOCATION:
sec. 33 T 6 N S R. 4 E W

_____ miles _____ of _____
(distance) (direction) (nearest town)

WELL PURPOSE: home
(home, irrigation, municipal, industrial)

WELL COMPLETION DATA:

(1) diameter (inches) 2"
(2) total depth (feet) 700

(3) static water level (feet) 10 below above
top of ground.

(4) casing PVC, 690,
(material) (depth)
_____ if telescope see back.
(size)

(5) screen 10', 690
(length) (depth to top)
2", PVC
(size) (material)

(6) pump 1 10
(HP) (yield gpm)
Elo
(type power)

(7) electric log NO
(yes or no)

(organization running log)

(8) how well bottom plugged 2" back
wash valve

DRILLERS REMARKS:

description of fomations encountered	from	to
top soil	1	10
red clay	10	190
fine water sand	190	330
dark blue clay	330	570
hard blue clay	570	690
good water sand	690	700


RECEIVED

AUG 20 1986

Department of Natural Resources
Bureau of Land & Water Resources

If well telescopes please sketch and show depths.

GROUND LEVEL

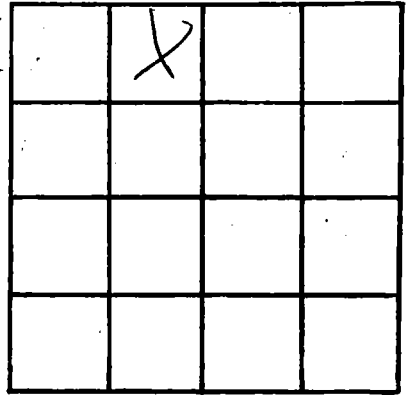

SECTION _____

Please indicate well location X.

ADDITIONAL INFORMATION

If more than one screen,
show locations of each on sketch.