

MISSISSIPPI DEPARTMENT OF NATURAL RESOURCES
Bureau of Land and Water Resources
 Southport Mall
 P.O. Box 10631
 Jackson, Mississippi 39209
WATER WELL DRILLERS LOG

Harrison
H
29/16

6/16/86 19____
 date well completed

COASTAL DRILLING & SERVICE CO. HARRISON
RT. 11, BOX 81 county well located

LANDOWNER: Jenkins

BILOXI, MS 39532 of formations encountered

from to

Jim Byrd Rd.

top soil

1 5

Biloxi, MS
 (mailing address)

red clay

5 185

dark blue clay

185 370

hard blue clay

370 660

fine water sand

660 680

good water sand

680 700

WELL LOCATION:

sec. 32 T. 6N S R. 10 E W

____ miles ____ of ____
 (distance) (direction) (nearest town)

WELL PURPOSE: home
 (home, irrigation, municipal, industrial)

WELL COMPLETION DATA:

(1) diameter (inches) 2"
 (2) total depth (feet) 700

(3) static water level (feet) 10 below above top of ground.

(4) casing PVC, 690
 (material) (depth)

____ if telescope see back.
 (size)

(5) screen 10', 690
 (length) (depth to top)

2", PVC
 (size) (material)

(6) pump 1, 10
 (HP) (yield gpm)

etc.
 (type power)

(7) electric log no
 (yes or no)

 (organization running log)

(8) how well bottom plugged 2" back
wash valve

DRILLERS REMARKS:


RECEIVED

AUG 20 1986

Department of Natural Resources
 Bureau of Land & Water Resources

If well telescopes please sketch and show depths.

GROUND LEVEL

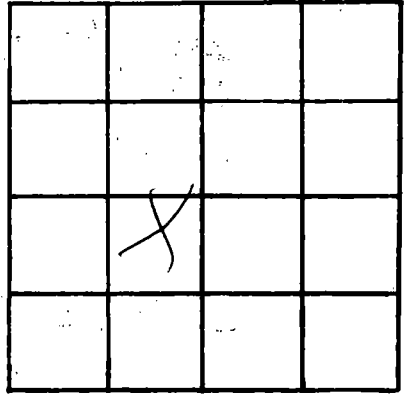

SECTION _____

Please indicate well location X.

ADDITIONAL INFORMATION

If more than one screen, show locations of each on sketch.