

MISSISSIPPI DEPARTMENT OF NATURAL RESOURCES

Bureau of Land and Water Resources

Southport Mall

P.O. Box 10631

Jackson, Mississippi 39209

COASTAL TOWER PIPES & DRILLERS LOG SERVICE CO.

RT. 11, BOX 81

BILOXI, MS 39532

Harrison

county well located

Harrison  
H  
2417

6/16/54

date well completed

19

LANDOWNER: Leslie Byrd, Jr.

description of formations encountered

from

to

Daisy Vestered.

top soil

1

5

Below: 4MS

red clay

5

200

(mailing address)

fine water sand

200

235

good water sand

235

245

WELL LOCATION:

sec. 36 T. 12 N. S

R. 10 E. W

(distance) miles (direction) of (nearest town)

WELL PURPOSE: home  
(home, irrigation, municipal, industrial)

WELL COMPLETION DATA:

- (1) diameter (inches) 2"
- (2) total depth (feet) 245
- (3) static water level (feet) 10 below above top of ground.

- (4) casing pvc, 235,  
(material) (depth)  
(size) If telescope see back.

- (5) screen 10', 235  
(length) (depth to top)  
2", pvc  
(size) (material)

- (6) pump 1, 10  
(HP) (yield gpm)  
etc.  
(type power)

- (7) electric log no  
(yes or no)  
  
(organization running log)

- (8) how well bottom plugged 2" back  
wash valve.

DRILLERS REMARKS:


RECEIVED

AUG 26 1954

Department of Natural Resources  
Bureau of Land & Water Resources

If well telescopes please sketch and show depths.

GROUND LEVEL

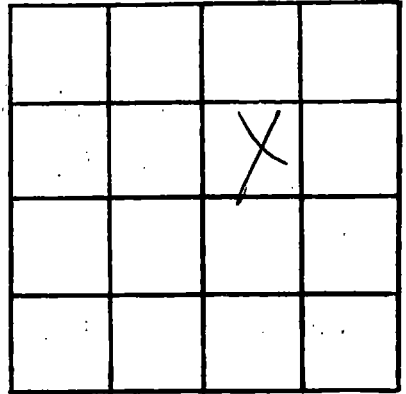

SECTION \_\_\_\_\_

Please indicate well location X.

ADDITIONAL INFORMATION

If more than one screen, show locations of each on sketch.