

MISSISSIPPI DEPARTMENT OF NATURAL RESOURCES

Bureau of Land and Water Resources

Southport Mall

P.O. Box 10631

Jackson, Mississippi 39209

WATER WELL DRILLERS LOG

COASTAL DRILLING & SERVICE CO.

HARRISON
H
2418

6/20/86

date well completed

RT. 11, BOX 81

BILOXI, MS 39532

county well located

LANDOWNER: C.M. Green

description of formations encountered

from

to

Dutchwood Rd.

top soil

1

5

red clay

8

100

red white clay

100

360

red white clay

360

445

good water sand

445

460

WELL LOCATION:

sec 21 T 6N S R 9 E W

_____ miles (distance) _____ of _____ (direction) _____ of _____ (nearest town)

WELL PURPOSE: home
 (home, irrigation, municipal, industrial)

WELL COMPLETION DATA:

(1) diameter (inches) 4" x 2"

(2) total depth (feet) 460'

(3) static water level (feet) 15 below above top of ground.

(4) casing PVC, 445,
 (material) (depth)

(size) If telescope see back.

(5) screen 15', 445
 (length) (depth to top)

2", PVC
 (size) (material)

(6) pump 1, 10
 (HP) (yield gpm)

ELC.
 (type power)

(7) electric log no
 (yes or no)

(organization running log)

(8) how well bottom plugged 2" back
wash valve

DRILLERS REMARKS:

RECEIVED


AUG 20 1986

Department of Natural Resources
 Bureau of Land & Water Resources

If well telescopes please sketch and show depths.

GROUND LEVEL

160' 4" PVC casing

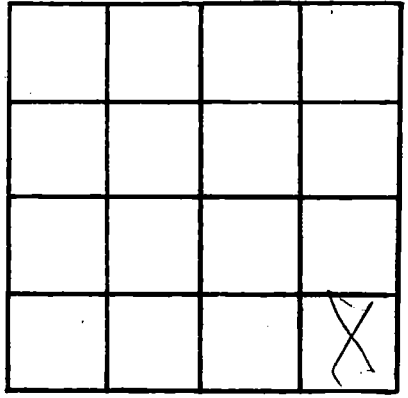

SECTION _____

Please indicate well location X.

ADDITIONAL INFORMATION

250' 2" PVC casing

15' 2" PVC screen

2" backwash valve

If more than one screen, show locations of each on sketch.