

MISSISSIPPI DEPARTMENT OF NATURAL RESOURCES

Bureau of Land and Water Resources

Southport Mall

P.O. Box 10631

Jackson, Mississippi 39209

WATER WELL DRILLERS LOG

COASTAL DRILLING & SERVICE CO.

Harrison
H
2419

6/20/86 19
 date well completed

RT. 11, BOX 81

Harrison
 county well located

LANDOWNER: Fred Jandy

Woodruff Drive

Biloxi, MS

(mailing address)

WELL LOCATION:

sec. 19 T. 6 N. R. 10 E.
 S W

_____ miles _____ of _____
 (distance) (direction) (nearest town)

WELL PURPOSE: home
 (home, irrigation, municipal, industrial)

WELL COMPLETION DATA:

- (1) diameter (inches) 2
- (2) total depth (feet) 660
- (3) static water level (feet) 10 below above
 top of ground.

(4) casing PVC, 650,
 (material) (depth)

_____ if telescope see back.
 (size)

(5) screen 10', 650
 (length) (depth to top)

2", PVC
 (size) (material)

(6) pump _____ (HP) _____ (yield gpm)

etc.
 (type power)

(7) electric log no
 (yes or no)

_____ (organization running log)

(8) how well bottom plugged 2" back
wood drive

DRILLERS REMARKS:

description of formations encountered

from

to

top soil

1 15

red clay

15 600

fine water sand

600 640

good water sand

640 1660


RECEIVED

AUG 20 1986

Department of Natural Resources
 Bureau of Land & Water Resources

If well telescopes please sketch and show depths.

GROUND LEVEL

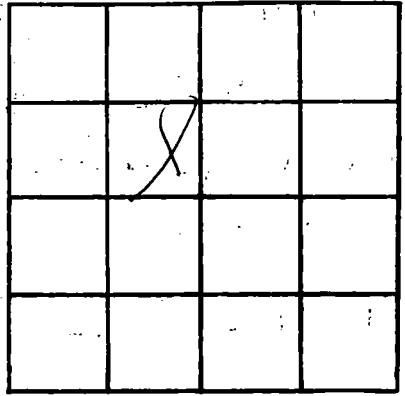

SECTION _____

Please indicate well location X.

ADDITIONAL INFORMATION

If more than one screen,
show locations of each on sketch.