

MISSISSIPPI DEPARTMENT OF NATURAL RESOURCES

Bureau of Land and Water Resources

Southport Mall

P.O. Box 10631

Jackson, Mississippi 39209

COASTER WELLS DRILLERS LOG & SERVICE CO.

RT. 11, BOX 81

Harrison

BILOXI, MS 39532

county well located

HARRISON
#
2420

6/25/86 19
date well completed

LANDOWNER: Diesel Supply
Biloxi, MS
(mailing address)

description of formations encountered	from to	
top soil	1	3
red clay	3	220
good weather sand	220	240

WELL LOCATION:
sec. 10 T 6 S R. 9 E 10 W
miles _____ of _____
(distance) (direction) (nearest town)

WELL PURPOSE: home
(home, irrigation, municipal, industrial)

WELL COMPLETION DATA:

(1) diameter (inches) 2"

(2) total depth (feet) 240

(3) static water level (feet) 10 below top of ground.

(4) casing PVC, 230,
(material) (depth)
_____ if telescope see back.
(size)

(5) screen 10', 230
(length) (depth to top)
2", PVC
(size) (material)

(6) pump 1, 9
(HP) (yield gpm)
etc.
(type power)

(7) electric log no
(yes or no)

(organization running log)

(8) how well bottom plugged, 2" back
wash valve


RECEIVED
AUG 19 1986

Department of Natural Resources
Bureau of Land & Water Resources

DRILLERS REMARKS:

If well telescopes please sketch and show depths.

GROUND LEVEL

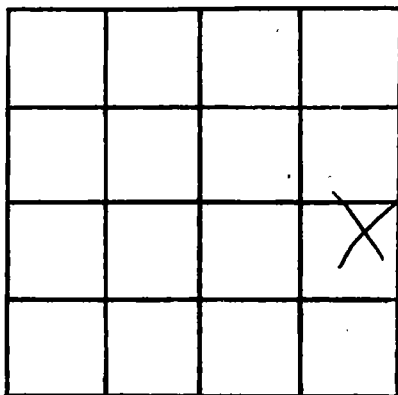

SECTION _____

Please indicate well location X.

ADDITIONAL INFORMATION

A series of horizontal lines for writing additional information, starting below the 'ADDITIONAL INFORMATION' header and extending to the bottom of the page.

If more than one screen, show locations of each on sketch.