

MISSISSIPPI DEPARTMENT OF NATURAL RESOURCES

Bureau of Land and Water Resources

Southport Mall

P.O. Box 10631

Jackson, Mississippi 39209

WATER WELL DRILLERS LOG

Harrison
H
2423

7-22-86 19 Coahoma water well Harrison
 date well completed firm name county well located

LANDOWNER: Robert Rowland
128 Lamey Lane
Biloxi, MS. 39531
 (mailing address)

WELL LOCATION:
 sec. 19 T. 6 N. R. 9 E.
7 miles NORTH of Biloxi
 (distance) (direction) (nearest town)

WELL PURPOSE: home
 (home, irrigation, municipal, industrial)

WELL COMPLETION DATA:

(1) diameter (inches) 2"
 (2) total depth (feet) 235'
 (3) static water level (feet) 37 below top of ground.
 (4) casing PVC, 220'
 (material) (depth)
2"
 (size) If telescope see back.
 (5) screen 10', 220'
 (length) (depth to top)
2" PVC
 (size) (material)
 (6) pump 1 10
 (HP) (yield gpm)
Elect
 (type power)
 (7) electric log no
 (yes or no)
 (organization running log)

(8) how well bottom plugged backward valve

DRILLERS REMARKS:
5 ft 2" Rect pipe

Description of formations encountered	from	to
Top Soil	0	4
Red Coarse Sand	4	30
Red Clay + Streak of Sand	30	45
Red Coarse Sand + Gravel	45	74
Blue Clay	74	189
Blue Clay + Streak of Sand	189	210
Gray Coarse Sand	210	230
Blue Clay	230	235


RECEIVED

AUG 27 1986

Department of Natural Resources
 Bureau of Land & Water Resources

If well telescopes please sketch and show depths.

GROUND LEVEL

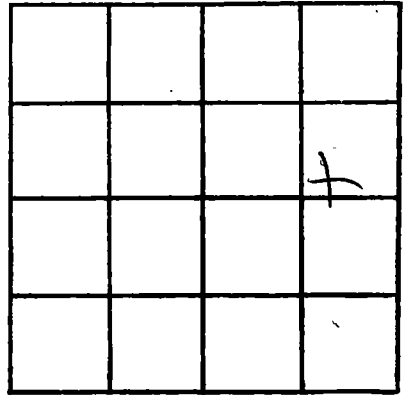

SECTION 19

Please indicate well location X.

ADDITIONAL INFORMATION

Lined area for additional information.

If more than one screen, show locations of each on sketch.