

MISSISSIPPI DEPARTMENT OF NATURAL RESOURCES

Bureau of Land and Water Resources

Southport Mall

P.O. Box 10631

Jackson, Mississippi 39209

WATER WELL DRILLERS LOG

HARRISON
H
2424

7-31-86 19 Cond water well Harrison
 date well completed firm name county well located

LANDOWNER: Edward Johnson
Rt 2 Box 306 B-18
Belair mo 39532
 (mailing address)

WELL LOCATION:
 sec 28 T 6 N R 9 E
2 1/2 miles N of DIBERVILLE
 (distance) (direction) (nearest town)

WELL PURPOSE: home
 (home, irrigation, municipal, industrial)

- WELL COMPLETION DATA:
- (1) diameter (inches) 2"
 - (2) total depth (feet) 310 ft.
 - (3) static water level (feet) 80 below above top of ground.
 - (4) casing PVC, 295 ft
 (material) (depth)
2" if telescope see back.
 (size)
 - (5) screen 10 ft, 295 ft
 (length) (depth to top)
2" PVC
 (size) (material)
 - (6) pump 1 5
 (HP) (yield gpm)
elect
 (type power)
 - (7) electric log no
 (yes or no)
 (organization running log)
 - (8) how well bottom plugged backwater valve

description of formations encountered	depth	
	from	to
Top soil	0	2
Red Sand	2	4
Blue Clay	4	27
White Sand + Peablaw	27	69
Blue Clay	69	142
Gray med Sand	142	165
Blue Clay	165	190
med Gray Sand	190	213
Blue Clay	213	265
med Gray Sand	265	275
Blue Clay w/ streaks of sand	275	284
Gray med Sand	284	305
Blue Clay	305	310


RECEIVED
 SEP 11 1986

DRILLERS REMARKS:
5' - 2" PUCT as pipe

Department of Natural Resources
 Bureau of Land & Water Resources

If well telescopes please sketch and show depths.

GROUND LEVEL

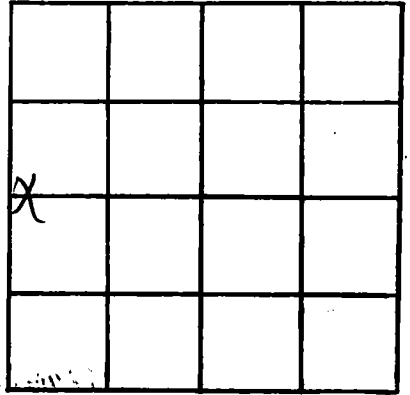

SECTION 28

Please indicate well location X.

ADDITIONAL INFORMATION

Lined area for additional information.

If more than one screen, show locations of each on sketch.