

MISSISSIPPI DEPARTMENT OF NATURAL RESOURCES

Bureau of Land and Water Resources

Southport Mall

P.O. Box 10631

Jackson, Mississippi 39209

WATER WELL DRILLERS LOG

HARRISON
A
2425

July 12 1986 McBell Pump Well Harrison  
 date well completed firm name county well located

LANDOWNER: Robert Leusch  
108 Lakeview  
Biloxi, Ms 39531  
 (mailing address)

description of formations encountered	from	to
Sand	0	30

WELL LOCATION:  
 sec. 35 T. 6 N. R. 10 E.  
Biloxi  
 miles (distance) (direction) of (nearest town)

WELL PURPOSE: irrigation  
 (home, irrigation, municipal, industrial)

- WELL COMPLETION DATA:
- (1) diameter (inches) 2"
  - (2) total depth (feet) 30'
  - (3) static water level (feet) 2' below above top of ground
  - (4) casing PVC, 20'  
 (material) (depth)  
2" If telescope see back.  
 (size)
  - (5) screen 10', Bottom  
 (length) (depth to top)  
2", PVC  
 (size) (material)
  - (6) pump 1/2, 8  
 (HP) (yield gpm)  
electric  
 (type power)
  - (7) electric log no  
 (yes or no)  
 (organization running log)
  - (8) how well bottom plugged Seal

RECEIVED


AUG 26 1986

Department of Natural Resources  
 Bureau of Land & Water Resources

DRILLERS REMARKS:

If well telescopes please sketch and show depths.

GROUND LEVEL

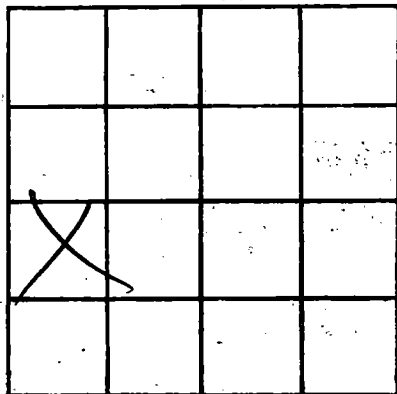

SECTION \_\_\_\_\_

Please indicate well location X.

ADDITIONAL INFORMATION

If more than one screen, show locations of each on sketch.