

HARRISON
H 2427

MISSISSIPPI
BOARD OF WATER COMMISSIONERS
416 North State Street
Jackson, Mississippi 39201

WATER WELL DRILLERS LOG

9-17-86
date well completed

R. J. Mooker
firm name

HARRISON
county well located


LANDOWNER: <u>Alfred Baraque</u>	description of formations encountered	from	to
<u>Three Rivers RD</u>			
<u>Only part, MS</u> (mailing address)	<u>Reddish to clay</u>	<u>0</u>	<u>60</u>
	<u>white clay</u>	<u>60</u>	<u>100</u>
	<u>Blue clay</u>	<u>100</u>	<u>380</u>
	<u>fine to med grey</u>		
	<u>shnd</u>	<u>380</u>	<u>400</u>
	<u>med shnd</u>	<u>400</u>	<u>420</u>
WELL LOCATION: sec. <u>8</u> T. <u>6</u> N. R. <u>10</u> E <u>4</u> miles <u>W</u> of <u>Leola</u> (distance) (direction) (nearest town)			
WELL PURPOSE: (home) irrigation, municipal, industrial			
WELL COMPLETION DATA:			
(1) diameter (inches) <u>2"</u>			
(2) total depth (feet) <u>420'</u>			
(3) static water level (feet) <u>50'</u> ^{below} / _{above} top of ground.			
(4) casing <u>PVC</u> <u>420'</u> (material) (depth)			
(size) if telescope see back.			
(5) screen <u>10'</u> <u>420'</u> (length) (depth to top)			
<u>2"</u> <u>PVC</u> (size) (material)			
(6) pump _____ (HP) (yield gpm)			
(type power)			
(7) electric log _____ (yes or no)			
(organization running log)			
(8) how well bottom plugged <u>Baraque</u>			
DRILLERS REMARKS:			

RECEIVED
JAN 02 1987

Department of Natural Resources
Bureau of Land & Water Resources

If well telescopes please sketch and show depths.

GROUND LEVEL

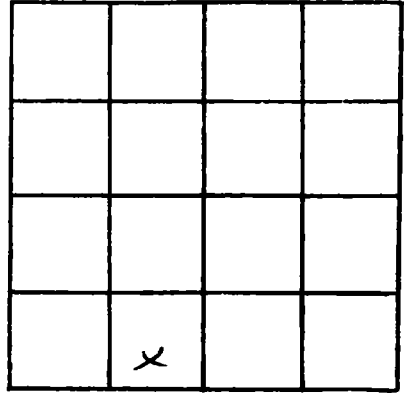

SECTION 8

Please indicate well location X.

ADDITIONAL INFORMATION

A series of horizontal lines for writing additional information, located below the 'ADDITIONAL INFORMATION' header.

If more than one screen, show locations of each on sketch.