

HARRISON
H
2428

**MISSISSIPPI
 BOARD OF WATER COMMISSIONERS**
 416 North State Street
 Jackson, Mississippi 39201
WATER WELL DRILLERS LOG

10-31-86 19 R. J. Moore HARRISON
 date well completed firm name county well located


LANDOWNER: <u>Tenny Creech</u> <u>HUDSON - KROHN RD</u> <u>WOOLMARIE</u>	description of formations encountered	from	to
<u>Biloxi MS</u> (mailing address)	<u>Top Soil & Silty S</u>	<u>0</u>	<u>40</u>
WELL LOCATION:	<u>White & Blue Clay</u>	<u>40</u>	<u>60</u>
sec. <u>36</u> T. <u>6</u> N R. <u>10</u> E	<u>Blue Clay</u>	<u>60</u>	<u>290</u>
<u>8</u> miles <u>E</u> of <u>Andover</u> (distance) (direction) (nearest town)	<u>Coarse Gray Silty S</u>	<u>290</u>	<u>320</u>
WELL PURPOSE: (home, irrigation, municipal, industrial)			
WELL COMPLETION DATA:			
(1) diameter (inches) <u>2"</u>			
(2) total depth (feet) <u>320</u>			
(3) static water level (feet) <u>60'</u> <u>below</u> above top of ground.			
(4) casing <u>PVC</u> , <u>320</u> (material) (depth)			
_____ if telescope see back. (size)			
(5) screen <u>10'</u> , <u>320</u> (length) (depth to top)			
<u>2"</u> , <u>PVC</u> (size) (material)			
(6) pump <u>1</u> , <u>8</u> (HP) (yield gpm)			
<u>F</u> (type power)			
(7) electric log _____ (yes or no)			
_____ (organization running log)			
(8) how well bottom plugged <u>Partial</u>			
DRILLERS REMARKS:			

RECEIVED
 JAN 02 1987

Department of Natural Resources
 Bureau of Land & Water Resources

If well telescopes please sketch and show depths.

GROUND LEVEL

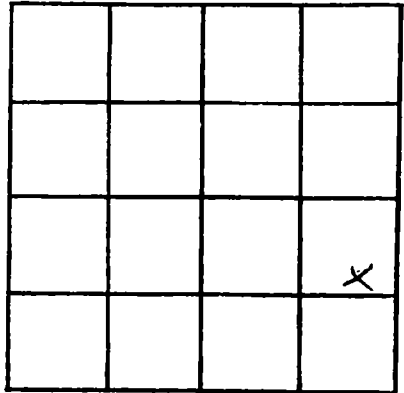

SECTION 36

Please indicate well location X.

ADDITIONAL INFORMATION

If more than one screen,
show locations of each on sketch.