

HARRISON
H
2429

MISSISSIPPI
 BOARD OF WATER COMMISSIONERS
 416 North State Street
 Jackson, Mississippi 39201

WATER WELL DRILLERS LOG

12-30-86 19 R Moore HARRISON
 date well completed firm name county well located


LANDOWNER: <u>WILLIE GUINN</u>	description of formations encountered	from	to
<u>BLONDA DRIVE</u> <u>BILOXI RIVER ESTATES</u> <u>C. C. SPORTS MS</u> (mailing address)			
WELL LOCATION: sec. <u>31</u> T. <u>6</u> N. R. <u>10</u> E <u>2</u> miles <u>W</u> of <u>Ward</u> (distance) (direction) (nearest town)	<u>TOP SOIL & SAND</u>	<u>0</u>	<u>30</u>
WELL PURPOSE: (home, irrigation, municipal, industrial)	<u>WHITE CLAY</u>	<u>30</u>	<u>90</u>
WELL COMPLETION DATA:	<u>WHITE SAND</u>	<u>90</u>	<u>120</u>
(1) diameter (inches) <u>2"</u>	<u>Blue Clay</u>	<u>120</u>	<u>460</u>
(2) total depth (feet) <u>460'</u>	<u>med sand</u>	<u>460</u>	<u>420</u>
(3) static water level (feet) <u>50</u> ^{below} _{above} top of ground.	<u>Coarse Sand</u>	<u>420</u>	<u>460</u>
(4) casing <u>PVC</u> <u>460</u> (material) (depth)			
(size) if telescope see back.			
(5) screen <u>10'</u> <u>460</u> (length) (depth to top)			
(size) <u>2</u> (material) <u>PVC</u>			
(6) pump <u>1</u> <u>8</u> (HP) (yield gpm)			
(type power) <u>E</u>			
(7) electric log _____ (yes or no)			
(organization running log) _____			
(8) how well bottom plugged <u>Bottom</u>			
DRILLERS REMARKS:			

RECEIVED
 JAN 02 1987

Department of Natural Resources
 Bureau of Land & Water Resources

If well telescopes please sketch and show depths.

GROUND LEVEL

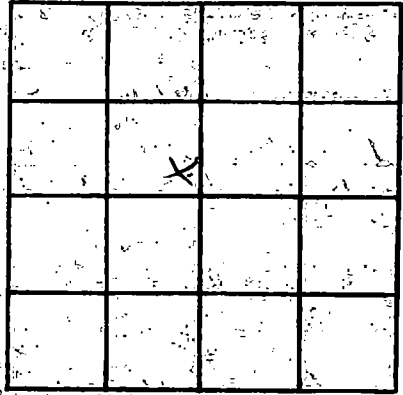

SECTION 31

Please indicate well location X.

ADDITIONAL INFORMATION

If more than one screen, show locations of each on sketch.