

MISSISSIPPI DEPARTMENT OF NATURAL RESOURCES

Bureau of Land and Water Resources

P.O. Box 10631

Jackson, Mississippi 39209

WATER WELL DRILLERS LOG

COUNTY WELL LOCATED HARRISON	
WELL NUMBER H 2433	CODED
DATE WELL COMPLETED 12-20-86	

PERMIT NUMBER
NAME OF DRILLING FIRM Coast Water Well

NAME & MAILING ADDRESS OF LANDOWNER LA Tucker		
Lamey Acres		
Biloxi, Ms.		
WELL LOCATION: SEC	TOWNSHIP	RANGE
18	6 N	9 W
DISTANCE 7 1/2 Miles	DIRECTION N	NEAREST TOWN of Biloxi
OTHER LANDMARK		
WELL PURPOSE: Home, Irrigation, Municipal, Industrial, Fish Pond, etc. home		

PUMP DATA		
PUMP TYPE (Circle One): Submersible, Turbine, - Jet Flowing Well, Other (Describe) _____		
POWER TYPE (Circle One): Electric, Tractor, Diesel, Gasoline, Butane, Other (Describe) _____		
Pump Capacity (GPM) 10	No. of Stages 2	Setting Depth FT.
PUMP TEST		
Well yielded _____ GPM with a drawdown of _____ ft. after _____ hours of pumping		


WELL DATA		
Well Depth 235'	Casing Diameter (In.) 2"	Casing Length (Ft.) 220'
Type of Casing PUC	Hole Depth 235'	Depth to Static Water Level 30'
TYPE OF COMPLETION: (Circle One or More): Gravel Packed, Underreamed, Telescoped, Natural Development, Open Hole, Other (Describe) _____		
Top of Lap Pipe or Reduction in Casing FEET IF TELESCOPED OR MORE THAN ONE SCREEN: USE BACK PAGE		

LOG DATA	
TYPE OF LOG RUN (Circle One): Electric, Gamma Ray, Density, Sonic, Neutron, Other (Describe) _____	
Name of Organization Running Log	

SCREEN DATA		
Diameter - Inches 2"	Length - Feet 10'	Slot Size - Inches 008
Screen Type PUC		Depth to Bottom - Feet 230'

GEOLOGIC DATA (Office Use Only)			
Surface Elev.	Geologic Unit	Unit Thickness	Depth to Top
Subs. SWL	Date	Analysis	Aquifer Test
Driller's Remarks			

DESCRIPTION OF FORMATIONS ENCOUNTERED	FROM	TO
Top Soil	0	2
white coarse sand	2	30
Red Gravel	30	80
Blue Clay	80	205
Gray coarse sand	205	230
Blue Clay	230	235

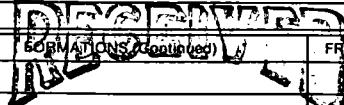

FORMATIONS (continued)

MAY 21 1987

Department of Natural Resources
Bureau of Land & Water Resources

DESCRIPTION OF FORMATIONS ENCOUNTERED	FROM	TO

IF MORE SPACE IS NEEDED, USE BACK

If well telescopes please sketch and show depths.

GROUND LEVEL

X			
	R		

SECTION 18

Please indicate well location X.

ADDITIONAL INFORMATION

If more than one screen,
show location of each on sketch.