

**MISSISSIPPI DEPARTMENT OF NATURAL RESOURCES**  
Bureau of Land and Water Resources

P.O. Box 10631  
Jackson, Mississippi 39209  
**WATER WELL DRILLERS LOG**

LOCATED	<i>Prison</i>
NUMBER	<i>H 2835</i>
CODED	
DATE WELL COMPLETED	<i>4-05-87</i>

PERMIT NUMBER	<i>0-239</i>
NAME OF DRILLING FIRM	<i>REGRELL PUMP &amp; WELLS RT1 BOX 1643 CANAL RD GUPT, MS 39503</i>

NAME & MAILING ADDRESS OF LANDOWNER			
<i>Bob Shira</i>			
<i>Wetzel rd</i>			
<i>Biloxi, Mo.</i>			
WELL LOCATION:	SEC	TOWNSHIP	RANGE
	<i>22</i>	<i>6 N</i>	<i>10 E</i>
DISTANCE	DIRECTION	NEAREST TOWN	
<i>3</i> Miles	<i>N</i>	of <i>Biloxi</i>	
OTHER LANDMARK			
WELL PURPOSE: <input checked="" type="checkbox"/> Home, <input type="checkbox"/> Irrigation, <input type="checkbox"/> Municipal, <input type="checkbox"/> Industrial, <input type="checkbox"/> Fish Pond, etc.			


<b>PUMP DATA</b>		
PUMP TYPE (Circle One): Submersible, Turbine, <input checked="" type="radio"/> Jet, <input type="radio"/> Flowing Well, Other (Describe) _____		
POWER TYPE (Circle One): <input checked="" type="radio"/> Electric, <input type="radio"/> Tractor, <input type="radio"/> Diesel, <input type="radio"/> Gasoline, <input type="radio"/> Butane, Other (Describe) _____		
Pump Capacity (GPM)	No. of Stages	Setting Depth
<i>10-15</i>	<i>2</i>	<i>60'</i> FT.
PUMP TEST		
Well yielded <i>10</i> GPM with a drawdown of <i>5</i> ft. after <i>1</i> hours of pumping		

<b>WELL DATA</b>		
Well Depth	Casing Diameter (In.)	Casing Length (Ft.)
<i>30'</i>	<i>2"</i>	<i>30'</i>
Type of Casing	Hole Depth	Depth to Static Water Level
<i>PVC</i>		<i>40'</i>
TYPE OF COMPLETION: (Circle One or More): Gravel Packed, Underreamed, Telescoped, Natural Development, Open Hole, Other (Describe) _____		
Top of Lap Pipe or Reduction in Casing		
FEET	IF TELESOPED OR MORE THAN ONE SCREEN: USE BACK PAGE	

<b>LOG DATA</b>	
TYPE OF LOG RUN (Circle One): <input checked="" type="radio"/> Electric, <input type="radio"/> Gamma Ray, <input type="radio"/> Density, <input type="radio"/> Sonic, <input checked="" type="radio"/> No Log Run, <input type="radio"/> Neutron, Other (Describe) _____	
Name of Organization Running Log	


<b>SCREEN DATA</b>		
Diameter - Inches	Length - Feet	Slot Size - Inches
<i>2"</i>	<i>10'</i>	<i>1000</i>
Screen Type	Depth to Bottom - Feet	
<i>sch 40 PVC</i>		

<b>GEOLOGIC DATA (Office Use Only)</b>			
Surface Elev.	Geologic Unit	Unit Thickness	Depth to Top
Subs. SWL	Date	Analysis	Aquifer Test
Driller's Remarks			

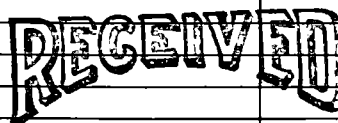DESCRIPTION OF FORMATIONS ENCOUNTERED	FROM	TO	FORMATIONS (Continued)	FROM	TO
 <b>MAY 27 1987</b>					
<b>Department of Natural Resources</b> <b>Bureau of Land &amp; Water Resources</b>					
IF MORE SPACE IS NEEDED, USE BACK					

If well telescopes please sketch and show depths.

GROUND LEVEL

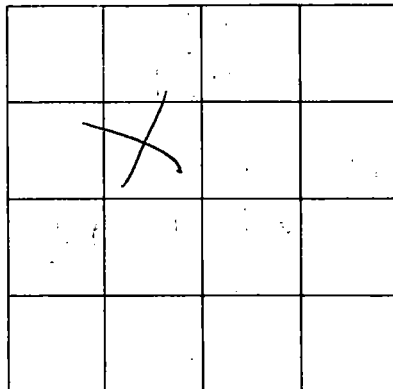

SECTION \_\_\_\_\_

Please indicate well location X.

ADDITIONAL INFORMATION

If more than one screen,  
show location of each on sketch.