

MISSISSIPPI DEPARTMENT OF NATURAL RESOURCES

Bureau of Land and Water Resources

Southport Mall

P.O. Box 10631

Jackson, Mississippi 39209

WATER WELL DRILLERS LOG

HARRISON
H
243P

Sept 1986 19  
date well completed

GENERAL DRILLING & SERVICE CO. Harrison  
firm name  
PT. 11, BOX 81  
county well located

LANDOWNER: BRUSEY Elbert  
BILBO, MS

description of formations encountered	from	to
top soil	1	9
Red clay	9	125
Soft blue clay	125	210
Hard blue clay	210	350
Red clay	350	380
fine water sand	380	400
good water sand	400	420

Below, MS

(mailing address)

WELL LOCATION:

sec. 3 T. 2 N. R. 90 E.  
S W  
Woolmarket  
(distance) miles (direction) of (nearest town)

WELL PURPOSE: home  
(home, irrigation, municipal, industrial)

WELL COMPLETION DATA:

- (1) diameter (inches) 4 x 2
- (2) total depth (feet) 420
- (3) static water level (feet) 15 below above top of ground.
- (4) casing PVC, 405, (material) (depth)  
4 x 2 (size) if telescope see back.
- (5) screen 15', 405 (length) (depth to top)  
2" PVC (size) (material)
- (6) pump 1 (HP) 11 (yield gpm)  
Elec. (type power)
- (7) electric log no (yes or no)

(organization running log)

(8) how well bottom plugged 2" back  
wash valve.

DRILLERS REMARKS:

RECEIVED

JUL 1 1987

Department of Natural Resources  
Bureau of Land & Water Resources

If well telescopes please sketch and show depths.


GROUND LEVEL

160' 4" pvc casing

260' 2" pvc casing

15' 2" pvc screen

2" back wash valve

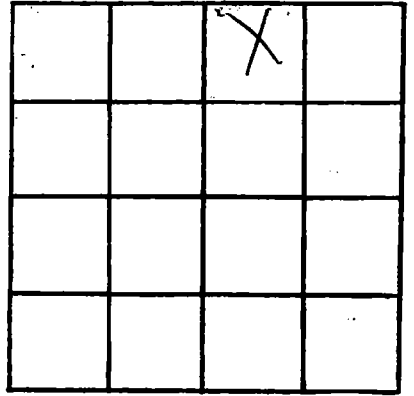

SECTION \_\_\_\_\_

Please indicate well location X.

ADDITIONAL INFORMATION

If more than one screen, show locations of each on sketch.