

MISSISSIPPI DEPARTMENT OF NATURAL RESOURCES

Bureau of Land and Water Resources

Southport Mall

P.O. Box 10631

Jackson, Mississippi 39209

WATER WELL DRILLERS LOG

COASTAL DRILLING & SERVICE CO. *Harrison*

RT. 11, BOX 84^e

county well located

<i>Harrison</i>
<i>H</i>
<i>2439</i>

Sept. 28 19 *86*
date well completed

LANDOWNER: *Dave Anderson*
RT. 1 Box 638
Biloxi, MS
(mailing address)

description of formations encountered	from	to
<i>top soil</i>	<i>1</i>	<i>10</i>
<i>Red clay</i>	<i>10</i>	<i>45</i>
<i>water sand</i>	<i>45</i>	<i>100</i>
<i>soft blue clay</i>	<i>100</i>	<i>340</i>
<i>hard blue clay</i>	<i>340</i>	<i>620</i>
<i>good water sand</i>	<i>620</i>	<i>640</i>
<i>fine water sand</i>	<i>640</i>	<i>660</i>

WELL LOCATION:
sec *34* T *6* N R *19* E
S W
Woburn market
(distance) (direction) (nearest town)

WELL PURPOSE: *home*
(home, irrigation, municipal, industrial)

WELL COMPLETION DATA:

- (1) diameter (inches) *4 x 2*
- (2) total depth (feet) *660*
- (3) static water level (feet) *15* below ~~above~~ top of ground.
- (4) casing *PVC*, *645*
(material) (depth)
4 x 2 if telescope see back.
(size)
- (5) screen *15'*, *645*
(length) (depth to top)
2", *PVC*
(size) (material)
- (6) pump *1*, *7*
(HP) (yield gpm)
Elec
(type power)
- (7) electric log *no*
(yes or no)
(organization running log)
- (8) how well bottom plugged *2" back*
wash valve

DRILLERS REMARKS:

RECEIVED

JUL 1 1987

Department of Natural Resources
Bureau of Land & Water Resources

If well telescopes please sketch and show depths.


GROUND LEVEL

160' 4" pvc casing

500' 2" pvc casing

15' 2" pvc screen

2" back wash valve,

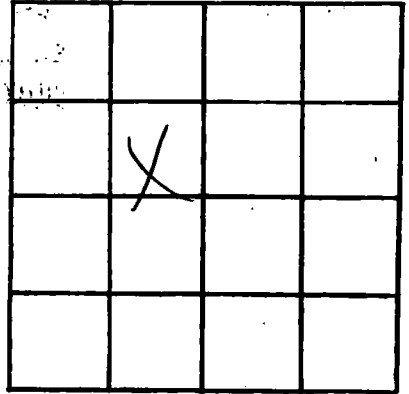

SECTION 2

Please indicate well location X.

ADDITIONAL INFORMATION

If more than one screen, show locations of each on sketch.