

MISSISSIPPI DEPARTMENT OF NATURAL RESOURCES

Bureau of Land and Water Resources

Southport Mall

P.O. Box 10631

Jackson, Mississippi 39209

WATER WELL DRILLERS LOG

COASTAL DRILLING & SERVICE CO.

BILOXI, MS 39532

HARRISON
H
2440

Oct 16

19 86

RT. 11, BOX 81

Harrison

date well completed

firm name

county well located

LANDOWNER: Ronnie Cuevas

description of formations encountered

from

to

Biloxi, MS

top poi

1

15

Red clay

15

75

hard blue clay

75

140

sand

140

185

very blue clay

185

300

pink water sand

300

320

good water sand

320

340

(mailing address)

WELL LOCATION:

sec. 7 T 10 N R 10 E S W

Woolmarket

(distance) (direction) of (nearest town)

WELL PURPOSE: home

(home, irrigation, municipal, industrial)

WELL COMPLETION DATA:

- (1) diameter (inches) 4 x 2
- (2) total depth (feet) 340
- (3) static water level (feet) 15 below above top of ground.

(4) casing PVC, 325 (material) (depth)

4 x 2 (size) if telescope see back.

(5) screen 15' 325 (length) (depth to top)

2" (size) PVC (material)

(6) pump 1 (HP) 8 (yield gpm)

Elec (type power)

(7) electric log no (yes or no)

(organization running log)

(8) how well bottom plugged 2" back wash valve

RECEIVED

JUL 1 1987

Department of Natural Resources
Bureau of Land & Water Resources

DRILLERS REMARKS:

If well telescopes please sketch and show depths.


GROUND LEVEL

160' 4" pvc casing

180' 2" pvc casing

15' pvc screen

2" back wash valve

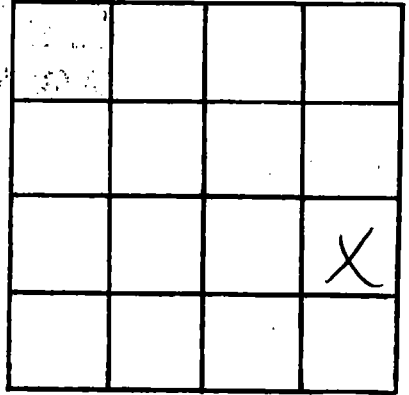

SECTION 7

Please indicate well location X.

ADDITIONAL INFORMATION

If more than one screen, show locations of each on sketch.