

MISSISSIPPI DEPARTMENT OF NATURAL RESOURCES

Bureau of Land and Water Resources

Southport Mall

P.O. Box 10631

Jackson, Mississippi 39209

COASTAL AERIAL PHOTOGRAPHY LOG

HARRISON
A
2441

Oct 17 1986  
date well completed

RT. 11, BOX 81

BILOXI, MS 39532

Harrison  
county well located

LANDOWNER: Reverend Jalen  
Biloxi, MS  
(mailing address)

description of formations encountered

from

to

top soil	1	20
red clay	20	105
soft blue clay	105	210
hard blue clay	210	280
fine water sand	280	300
good water sand	300	325

WELL LOCATION:  
sec. 24 T. 6 N. R. 10 E.  
S W  
Woodmarket  
(distance) (direction) (nearest town)

WELL PURPOSE: home  
(home, irrigation, municipal, industrial)

WELL COMPLETION DATA:

- (1) diameter (inches) 4 x 2
- (2) total depth (feet) 325
- (3) static water level (feet) 15 below above top of ground.
- (4) casing PVC, 310  
(material) (depth)  
4 x 2 if telescope see back.  
(size)
- (5) screen 15', 310  
(length) (depth to top)  
2", PVC  
(size) (material)
- (6) pump 1, 8  
(HP) (yield gpm)  
elec  
(type power)
- (7) electric log yes  
(yes or no)  
(organization running log)
- (8) how well bottom plugged 2" back  
wash valve

RECEIVED

JUL 1 1987

Department of Natural Resources  
Bureau of Land & Water Resources

DRILLERS REMARKS:

If well telescopes please sketch and show depths.

GROUND LEVEL


160" 4" pvc casing

165" 2" pvc casing

15' 10" pvc screen

2" back wash valve

If more than one screen, show locations of each on sketch.

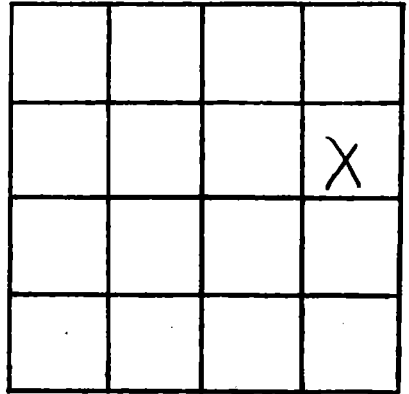

SECTION 2

Please indicate well location X.

ADDITIONAL INFORMATION

Multiple horizontal lines for additional information.